

V APPENDIX

V. APPENDIX

A. Sampling Program Results

1. Regular Test Stations

On the following pages in tabular form are the results of sampling data gathered throughout the course of the project at points selected for evaluation. Flows were measured at these stations by use of a 90° triangular V notch sharp crested weir inserted in a vitrified clay pipe or by use of Gurley current meter. Samples taken were sent to the Department of Environmental Resource's approved laboratory for testing.

Under the column entitled "Other" the results of special analysis have been shown to indicate the quantity of the following chemical substances:

<u>Chemical Substance</u>	<u>Symbol</u>
Ferrous Iron	Fe ₂
Aluminum	Al
Calcium	Ca

V. APPENDIX

A. SAMPLING PROGRAM RESULTS

Test Point No.	Date	Flow GPM	pH	Acidity		Total Iron		Sulfates		Alkalinity		Other PPM	
				PPM	lb/day	PPM	lb/day	PPM	lb/day	PPM	lb/day		
1	6-1-73	5702	3.3	150	10269	5.0	342	446	31494	0	0		
	6-27-73	2110	3.4	150	3800	18.0	456	490	12415	0	0		
	7-12-73	3726	3.4	190	8502	14.0	626	570	25504	0	0		
	8-2-73	1526	3.1	220	4032	13.0	238	600	10997	0	0		
	9-7-73	1796	3.1	210	4528	17.0	366	620	13369	0	0		
	10-19-73	808	3.2	220	2135	23.2	225	424	41144	0	0		
	11-25-73	50288	3.5	44	26566	25.7	15517	250	150,948	0	0		
	12-14-73	10461	3.1	140	17585	11.2	1407	380	47732	0	0		
	12-28-73	16164	3.2	80	15526	10.9	2113	310	60164	0	0		
	1-26-74	7363	3.4	94	8310	9.5	835	330	29176	0	0		
	2-16-74	4579	3.0	140	7698	13.6	747	475	26119	0	0		
	3-23-74	10461	3.7	88	11054	7.1	892	550	43964	0	0		
	Average	9582	3.2	144	10000	14.1	1981	454	41085				
	11	7-12-73	2	3.8	68	1	3.0	0.1	360	8.0	0	0	
		8-2-73	1	3.3	110	1	24.0	3.0	390	4.0	0	0	
9-7-73		.5	3.7	150	1	18	0.1	570	3.1	0	0		
11-25-73		.6	2.9	120	1	1.8	0.1	200	1.6	0	0		
12-14-73		.6	3.0	160	1	8.4	0.1	425	3.4	0	0		
12-28-73		2	3.0	100	3	12.5	0.3	345	9.3	0	0		
1-26-74		11.2	3.4	100	13	3.4	.5	325	43.8	0	0		
2-16-74		1.3	3.0	80	1	54.5	.9	200	3.2	0	0		
3-23-74		6.7	3.7	42	3	17.6	1.4	350	28.3	0	0		
Average	2.2	3.3	103	3	15.9	0.7	352	11.6					

Point on Little Toby Creek

Cartwright Mine to Little Toby Creek

V. APPENDIX

A. SAMPLING PROGRAM RESULTS

Test Point No.	Date	Flow GPM	pH	Acidity		Total Iron		Sulfates		Alkalinity		Other PPM
				PPM	lb/day	PPM	lb/day	PPM	lb/day	PPM	lb/day	
24	5-31-73	663	4.2	150	1221	0.4	3.0	1000	8140	0		
	6-26-73	166	4.1	120	239	1.55	3.0	720	1436	0		Al-14
	7-12-73	143	4.0	240	414	1.2	2.0	1300	2243	0		
	8-2-73	148	3.7	210	374	1.4	2.0	1300	3414	0		
	9-7-73	62	3.7	190	143	2.2	2.0	1300	981	0		
	10-19-73	71	4.1	204	175	0.89	0.8	1198	1033	0		
	11-25-73	1257	4.5	28	422	1.2	18.1	200	3019	0		
	12-14-73	538	4.0	138	893	0.74	4.8	1020	6599	0		
	12-28-73	251	3.9	100	301	0.29	0.9	745	2249	0		
	1-26-74	479	4.0	184	1057	.59	3.4	900	5172	0		
	2-16-74	139	3.8	204	340	.59	1.0	1025	1712	0		
	3-23-74	395	4.4	122	579	.44	2.1	850	4032	0		
	Average	359	4.0	157	615	2.0	3.5	964	3336			

Unnamed stream to Sawmill Run

Note: Al determined by AA method 129 std. meth.; 13th edition.

25	7-12-73	4.0	2.9	720	35	110	5	1200	58	0		
	8-2-73	3.6	2.5	930	40	150	6	1500	65	0		
	9-7-73	1.3	2.6	980	16	200	3	1700	27	0		
	10-10-73	1.1	2.7	900	12	190	3	1799	24	0		
	11-25-73	4.0	2.4	940	45	83	4	723	35	0		
	12-14-73	2.2	2.7	1180	32	62	2	1100	30	0		
	12-28-73	10.8	2.6	700	91	137	17	1200	155	0		
	1-26-74	3.8	2.8	540	25	109	5	725	33	0		
	2-16-74	9.0	2.5	560	1	196	21	825	88	0		
	3-23-74	3.8	3.1	620	28	65	3	850	39	0		
Average	4.3	2.6	807	32	167	7	1162	55				

Gavazzi Mine to Sawmill Run

V. APPENDIX

A. SAMPLING PROGRAM RESULTS

Test Point No.	Date	Flow GPM	pH	Acidity		Total Iron		Sulfates		Alkalinity		Other PPM
				PPM	lb/day	PPM	lb/day	PPM	lb/day	PPM	lb/day	
27	7-12-73	116	5.7	6	8	0.2	0.3	5	7			
	8-2-73	47	5.6	8	5	0.5	0.3	29	17			
	9-7-73	49	5.9	4	2	0.6	0.4	7	4			
	10-19-73	3.4	5.4	4	15	0.15	0.6	149	562	2	7	
	11-25-73	1674	4.6	8	161	1.05	21.0	250	5027	2	40	
	12-14-73	996	4.9	8	96	0.58	7.0	45	539	4	48	
	12-28-73	3143	4.1	60	2264	0	0	12	452.8		0	
	1-26-74	2101	4.2	6	151	.15	3.7	6	1514		0	
	2-16-74	553	4.8	8	53	.29	1.93	150	996.2		0	
	3-23-74	1149	5.3	4	55	0	0	40	552		0	
Average		1014	5.0	12	281	0.3	3.5	69	831	2.2	31	
28	6-1-73	49	3.0	280	166	11	7	590	350		0	
	6-26-73	22	3.1	260	70	36	10	780	210		0	
	7-12-73	13	3.2	320	52	27	4	610	99		0	
	8-2-73	9	2.9	580	63	24	3	660	71		0	
	9-7-73	6	3.0	340	27	20	2	650	53		0	
	10-19-73	3				18	1	649	24		0	
	11-25-73	20	2.7	280	68	9.71	2	349	85		0	
	12-28-73	57	3.0	100	69	31.85	22	355	246		0	
	1-26-74	58	.13	104	73	9.44	6.6	310	217		0	
	2-16-74	90	2.8	280	301	13.6	19.6	575	619		0	
	3-23-74	54	3.6	142	92	9.78	6.3	350	226		0	
Average		35	2.7	269	98	19.12	11	534	200			

Point on Sawmill Run

Dagus Mine Old Mine Opening to Sawmill Run

V. APPENDIX

A. SAMPLING PROGRAM RESULTS

Test Point No.	Date	Flow GPM	pH	Acidity		Total Iron		Sulfates		Alkalinity		Other PPM
				PPM	lb/day	PPM	lb/day	PPM	lb/day	PPM	lb/day	
43	5-31-73	754	3.0	390	3532	16	145	1000	9057	0		
	6-26-73	197	3.1	300	711	33	78	1200	2846	0		
	7-13-73	157	3.3	380	717	24	45	1100	2076	0		Fe ₂ -0.5 1
	8-2-73	125	3.0	160	241	19	29	1000	1509	0		Fe ₂ -1.0 2
	9-7-73	76	3.0	410	376	23	21	1100	1008	0		Fe ₂ -0.5 1
	10-19-73	62	3.1	400	302	19	14	649	490	0		
	11-25-73	67	2.7	460	372	23	19	825	667	0		
	12-14-73	121	3.0	318	463	17	26	1050	1428	0		
	12-28-73	134	3.0	380	616	27	44	850	1375	0		
	1-26-74	358	3.0	440	1897	38	164	900	3882	0		
	2-16-74	134	2.6	300	485	25	40	825	1334	0		
	3-23-74	561	3.3	350	2359	29	197	650	4380	0		

Average		228	3.0	357	1005	24	68	929	2504			Fe ₂ -0.7 1
54	5-31-73	336	3.2	200	808	4.1	16	1100	4448	0		
	6-26-73	112	3.3	150	202	7.0	9	600	809	0		
	7-13-73	31	3.4	210	79	5.1	2	1000	377	0		Al-15
	8-2-73	33	3.2	200	81	3.6	1	610	247	0		
	9-7-73	21	3.5	150	38	3.9	1	550	139	0		
	10-19-73	12	3.5	142	21	3.0	0.4	473	69	0		
	11-25-73	121	5.9	16	23	9.45	13	226	329	12	17	
	12-13-73	22	3.2	220	59	3.2	0.8	495	133	0		
	12-28-73	103	2.9	340	442	35.88	45	700	868	0		
	1-26-74	121	3.2	204	297	9.71	14	425	619	0		
	2-16-74	56	2.8	140	97	11.5	8	325	226	0		
	3-23-74	498	3.5	160	957	9.8	59	450	2693	0		

Average		122	3.5	178	257	8.85	14	580	913			

43 Toby Mine Caved Mine Opening
 54 Toby Mine Caved Mine Opening
 Dagus Mine Caved Mine to Little Foby Creek

Note Al determined by AA method 129 standard method 13th edition

V. APPENDIX

A. SAMPLING PROGRAM RESULTS

Test Point No.	Date	Flow GPM	pH	Acidity		Total Iron		Sulfates		Alkalinity		Other PPM
				PPM	lb/day	PPM	lb/day	PPM	lb/day	PPM	lb/day	
67	5-31-73	637	4.0	40	306	1.8	14	600	4593	0	0	
	6-26-73	179	3.5	98	211	4.8	10	430	927	0	0	
	7-13-73	76	3.6	130	119	6.3	6	370	339	0	0	
	8-2-73	85	3.2	140	143	5.2	5	450	461	0	0	
	9-7-73	58	3.3	150	105	60.0	4	410	287	0	0	
	10-19-73	107	3.3	122	158	4.7	6	424	584	0	0	
	11-25-73	471	3.2	64	362	7.3	42	175	991	0	0	
	12-13-73	431	3.7	94	486	4.9	25	295	1527	0	0	
	12-28-73	1676	3.9	46	926	3.0	61	210	4226	0	0	
	1-26-74	934	3.6	64	718	4.5	50	200	2243	0	0	
	2-16-74	370	3.1	60	266	6.2	27.6	275	1223	0	0	
	3-23-74	660	4.2	48	380	3.1	24.6	175	1837	0	0	

Point on Little Toby Creek

68	Average	473	3.6	88	348	9.3	23	334	1603	0	0	
	5-31-73	1014	3.7	64	780	0.4	5	280	3411	0	0	
	6-26-73	237	3.9	54	154	1.6	5	250	714	0	0	
	7-13-73	58	3.9	58	41	1.7	1	370	259	0	0	
	8-2-73	76	3.6	76	70	2.1	2	400	367	0	0	
	9-7-73	103	3.6	100	124	2.9	4	410	508	0	0	
	10-19-73	125	3.7	84	109	2.5	4	397	599	0	0	
	11-25-73	336	3.5	48	194	4.9	20	226	914	0	0	
	12-13-73	179	3.6	80	172	2.0	4	320	690	0	0	
	12-28-73	516	3.7	32	198	1.8	11	220	1364	0	0	
	1-26-74	727	4.9	12	105	.15	1	240	2096	0	0	
	2-16-74	377	3.5	34	151	1.0	4	225	1000	0	0	
	3-23-74	862	5	14	145	.67	7	305	3157	0	0	

Unnamed Stream to Little Toby Creek

Average 384 3.8 55 186 1.81 6 304 1257

V. APPENDIX

A. SAMPLING PROGRAM RESULTS

Test Point No.	Date	Flow GPM	pH	Acidity		Total Iron		Sulfates		Alkalinity		Other PPM	
				PPM	lb/day	PPM	lb/day	PPM	lb/day	PPM	lb/day		
73	6-4-73	4736	4.8	15	853	0.2	11	120	6825	0			
	6-27-73	1436	4.6	24	414	0.2	4	86	1483	0			
	7-13-73	471	4.7	22	124	1.0	6	160	906	0			
	8-2-73	237	4.5	52	149	0.4	1	290	829	0			
	9-7-73	471	4.6	40	226	.2	1	200	1132	0			
	10-19-73	709	4.7	20	170	.2	2	198	1687	2	17		
	11-25-73	13470	4.2	8	1293	1.8	291	150	24259	0	129		
	12-28-73	5388	4.5	8	518	0	0	60	3882	2			
	1-26-74	5148	4.6	24	1484	1.4	84	120	7418	0			
	2-16-74	2182	4.1	14	366	.2	4	200	5240	0			
	3-23-74	5698	5.0	14	958	0	0	95	6499	0			
	Average		3631	4.6	21	595	0.5	37	153	5469	2	73	
	74	5-31-73	547	3.9	110	723	1.0	7	1670	4406	0		
6-26-73		579	3.8	98	681	1.9	13	830	5772	0		Al-8.0	
7-12-73		345	3.8	130	540	2.1	9	890	3694	0			
8-2-73		139	3.7	110	184	1.1	2	940	1571	0			
9-7-73		130	3.7	110	171	1.2	2	970	1516	0			
10-19-73		148	4.3	92	163	1.1	2	799	1421	0			
11-25-73		4067	4.4	34	1660	10.1	488	224	10941	0			
12-14-73		700	4.2	90	757	2.1	17	650	5466	0			
12-28-73		754	3.8	62	562	2.6	24	530	4800	0			
1-26-74		1101	3.5	126	1666	8.9	118	525	6943	0			
2-16-74		943	3.4	60	679	5.8	65	550	6226	0			
3-28-74		503	4.0	90	568	4.9	31	425	2681	0			
Average			830	3.9	93	696	3.5	64	750	4620			

Note Al determined by AA method 129 standard method 13th edition

V. APPENDIX

A. SAMPLING PROGRAM RESULTS

Test Point No.	Date	Flow GPM	pH	Acidity		Total Iron		Sulfates		Alkalinity		Other PPM
				PPM	lb/day	PPM	lb/day	PPM	lb/day	PPM	lb/day	
75	5-31-73	4189	3.2	180	9053	6.8	342	420	21125	0	0	
	6-27-73	1167	3.3	170	2382	19.0	266	430	6027	0	0	
	7-12-73	2105	3.3	200	5057	14.0	354	480	12136	0	0	
	8-2-73	695	3.0	210	1754	14.0	117	550	4595	0	0	
	9-7-73	1126	3.1	220	2976	17.0	230	580	7848	0	0	
	10-19-73	1329	3.1	28	447	21.8	348	776	12383	0	0	
	11-25-73	9217	3.3	72	7969	10.9	1206	150	16602	0	0	
	12-14-73	2155	3.2	150	3881	13.6	351	410	10609	0	0	
	12-28-73	6824	3.2	160	13111	24.7	2027	395	32368	0	0	
	1-26-74	4777	3.3	144	8260	11.2	642	275	15774	0	0	
	2-16-74	1194	3.1	180	2037	19.4	219	300	3396	0	0	
	3-23-74	6497	3.6	128	9985	11.1	867	300	23402	0	0	
	Average	3439	3.2	153	5576	15.3	580	422	13855			

Kyler Run to Little Toby Creek

76	5-31-73	1517	4.4	78	1421	0.9	16	370	6742	0	0	Al-10 ⁰ Ca-119 ⁰
	6-26-73	148	4.0	100	178	2.2	4	480	854	0	0	
	7-12-73	188	4.2	150	340	2.2	5	460	1042	0	0	
	8-2-73	143	3.7	130	210	0.3	1	450	776	0	0	
	9-7-73	215	3.8	130	336	2.3	6	570	1474	0	0	
	10-19-73	1468	3.9	114	2009	2.3	41	602	10612	0	0	
	11-25-73	1796	3.7	88	1897	31.1	670	225	4852	0	0	
	12-13-73	345	4.2	114	473	3.7	15	345	1432	0	0	
	12-28-73	1185	4.4	5.0	712	1.8	26	245	3487	0	0	
	1-26-74	1329	4.6	50	798	2.0	32	280	4468	0	0	
	2-16-74	5029	4.1	88	5313	4.9	295	225	3585	0	0	
	3-23-74	700	4.8	48	404	2.2	18	225	1892	0	0	
	Average	1171	4.1	91	1174	4.6	94	373	3434			

Limestone Run to Little Toby Creek

Note: Al determined by AA method 129 standard method 13th edition
Ca determined by AA EPA method 203A standard method 13th edition

V. APPENDIX

A. SAMPLING PROGRAM RESULTS

Test Point No.	Date	Flow GPM	pH	Acidity PPM lb/day	Total Iron PPM lb/day	Sulfates PPM lb/day	Alkalinity PPM lb/day	Other PPM
77	5-31-73	130	4.7	12	0.2	170	0	
	6-26-73	35	4.5	14	0.3	370	0	
	7-13-73	22	4.7	20	0.5	240	0	
	8-2-73	26	4.5	20	0.7	250	0	
	9-7-73	29	4.6	7	1.3	250	0	
	10-19-73	49	4.9	12	7.6	271	4	2
	11-25-73	251	4.6	8	1.8	175	2	6
	12-13-73	116	4.8	32	6.2	205	4	5
	12-28-73	341	4.7	12	0	160	6	25
	1-26-74	172	4.8	16	.3	140	0	0
	2-16-74	170	4.6	10	.7	225	0	0
	3-23-74	3071	5.2	6	0	115	0	0

Little Foby Creek
 Unnamed Stream to
 Little Foby Creek

78	Average	367	4.7	14	1.6	214	4	9
	5-31-73	246	5.5	8	4.4	270	0	0
	6-26-73	242	5.5	26	18.0	270	0	0
	7-13-73	125	5.6	30	13.0	270	0	0
	8-2-73	80	5.3	44	16.0	340	0	0
	9-7-73	139	4.9	26	24.0	300	0	0
	10-19-73	89	5.3	44	30.6	314	6	6
	11-25-73	41	4.6	88	23.0	226	4	2
	12-13-73	139	3.5	74	24.7	275	0	0
	12-28-73	134	4.1	44	18.3	215	0	0
	1-26-74	263	5.3	10	5.0	235	0	0
	2-16-74	305	4.2	4	10.3	225	0	0
	3-23-74	269	5.1	74	4.9	200	0	0

Dagus Mine Air Seal to
 Little Foby Creek

Average 172 4.9 39 66 16.0 27 261 524 5 4

V. APPENDIX

A. SAMPLING PROGRAM RESULTS

Test Point No.	Date	Flow GPM	pH	Acidity		Total Iron		Sulfates		Alkalinity		Other PPM
				PPM	lb/day	PPM	lb/day	PPM	lb/day	PPM	lb/day	
81	7-13-73	9	3.3	220	24	39	4.2	560	60	0	0	Ca-110
	8-2-73	9	3.0	220	26	33	3.9	550	65	0	0	
	9-7-73	7	3.1	190	17	28	3.0	490	45	0	0	
	10-19-73	5	3.1	180	12	17.8	1.0	323	21	0	0	
	11-25-73	4	3.0	232	13	4.2	0.2	276	15	0	0	
	12-13-73	9	3.2	210	33	19.4	2.1	285	30	0	0	
	12-28-73	9	3.2	80	9	2.3	0.2	200	23	0	0	
	1-26-74	21	3.3	166	41	5.4	1.0	325	81	0	0	
	2-16-74	10	3.0	140	16	17.3	2.0	350	41.5	0	0	
	3-23-74	16	3.5	254	48	12.0	2.0	350	66	0	0	
	Average	10	3.2	189	24	17.8	2.0	371	45			

Dagus Mine Air Seal to Little Toby Creek

Note: Ca determined by AA EPA method 203A standard method 13th edition

85	8-24-73	2	3.2	130	3.5	5.2	0.1	600	16	0	0	
	9-7-73	4	3.3	140	7.5	5.4	0.3	600	32	0	0	
	10-9-73	3	3.4	124	5.4	26.1	1.1	451	19	0	0	
	12-13-73	1	3.3	122	1.9	2.8	.01	455	7	0	0	
	12-28-73	16	3.5	44	8.5	1.2	0.2	255	49	0	0	
	1-26-74	34	3.7	54	8.7	3.4	.5	225	36	0	0	
	2-16-74	22	3.4	80	21.4	2.2	.6	340	29	0	0	
	Average	23	3.5	96	8.0	5.9	0.4	404	33			

Kyler Mine Caved Mine Heading to Little Toby Creek

V. APPENDIX

A. SAMPLING PROGRAM RESULTS

Test Point No.	Date	Flow GPM	pH	Acidity		Total Iron		Sulfates		Alkalinity		Other		
				PPM	lb/day	PPM	lb/day	PPM	lb/day	PPM	lb/day	PPM	lb/day	
93 Kyler Mine Heading to Kyler Run Kyler Run	6-1-73	1526	3.0	240	4399	14.0	257	520	9531	0				
	6-26-73	915	3.1	180	1980	37.0	407	450	4949	0		Al-19		
	7-13-73	754	3.2	230	2083	29.0	263	500	4528	0	Fe2-	0.5	5	
	8-2-73	449	2.9	250	1347	29.0	156	560	3018	0	Fe2-	19.0	102	
	9-7-73	718	3.6	280	2415	33.0	285	600	5175	0	Fe2-	17.0	147	
	10-19-73	574	3.1	26	179	26.1	180	451	3112	0		---		
	11-25-73	651	2.9	200	1563	26.4	206	375	2931	0	Fe2-	6.7	52	
	12-13-73	790	3.0	350	3321	24.5	232	600	5693	0		---		
	12-28-73	1796	3.0	240	5175	35.2	759	450	9704	0	Fe2-	14.6	315	
	1-26-74	1347	3.1	212	3429	22.7	376	275	4448	0	Fe2-	5.6	91	
	2-16-74	1391	3.0	240	4010	31.0	518	275	4596	0	Fe2-	15.7	261	
	3-23-74	1751	3.3	240	5046	27.5	578	325	6833	0	Fe2-	15.7	330	
	Average		1054	3.1	224	2912	28.0	351	448	5376		Fe2-	11.8	163

65

94 Unnamed Stream from Stripping to Kyler Run Kyler Run	6-1-73	31	3.5	580	219	1.5	0.6	1200	453	0				
	6-26-73	13	3.5	600	97	2.2	0.4	1300	210	0		Al-95		
	7-13-73	7	3.6	230	20	2.6	0.2	1500	129	0		Al-130		
	8-2-73	10	3.3	730	86	2.5	0.3	1000	190	0				
	9-7-73	11	3.3	710	96	2.5	0.3	1700	229	0				
	10-19-73	10	3.6	760	82	0.9	0.1	1398	151	0				
	11-25-73	62	3.3	32	24	0.7	0.5	976	736	0				
	12-9-73	59	3.5	920	654	1.36	0.9	1050	747	0				
	12-28-73	179	3.4	542	1169	2.01	4.3	1065	2297	0				
	1-26-74	153	3.4	542	993	12.6	9.5	600	453	0				
	2-16-74	53	3.6	526	337	1.0	.7	900	577	0				
	3-23-74	63	3.9	340	257	12.6	9.5	600	453	0				
	Average		54	3.5	542	336	3.3	2.2	1105	552				

Note: Al determined by AA method 129 standard method 13th edition
Ca determined by AA EPA method 203A standard method 13th edition

A. SAMPLING PROGRAM RESULTS

Test Point No.	Date	Flow GPM	pH	Acidity		Total Iron		Sulfates		Alkalinity		Other
				PPM	lb/day	PPM	lb/day	PPM	lb/day	PPM	lb/day	
97	6-1-73	498	6.4			0.8	5	34	203	20	120	
	6-27-73	170	6.7			1.6	3	53	109	30	61	
	7-13-73	188	6.4			1.8	4	57	129	30	68	Fe ₂ -0.5
	8-2-73	27	6.6			1.4	0.5	38	12	34	11	
	9-7-73	22	6.7			1.6	0.4	36	9.7	52	14	
	10-19-73	18	6.4	2.0	0.4	4.3	0.9	34	7.3	62	13	
	11-25-73	45	6.7	8	4.3	1.0	0.5	225	121	44	24	
	12-9-73	266	6.5	10	32	6.2	19	95	304	80	256	
	12-28-73	404	4.8	12	58	4.9	24	120	582	6	29	
	1-26-74	524	4.9	32	201	4.2	26	100	629	72	5	
	2-16-74	5	6.2	6	0.4	1.5	0.1	125	8.1	0	0	
	3-23-74	524	6.2	12	76	6.4	40	80	505	0	0	

Stream to Unnamed
Kyler Run

Test Point No.	Date	Flow GPM	pH	Acidity		Total Iron		Sulfates		Alkalinity		Other
				PPM	lb/day	PPM	lb/day	PPM	lb/day	PPM	lb/day	
99	Average	224	6.2	11	60.0	3.0	10.0	83	218	43	60	Fe ₂ -0.5
	6-1-73	1373	3.4	120	647	5.4	89	380	6268	0	0	
	6-26-73	473	3.5	98	581	8.9	53	590	3499	0	0	
	7-13-73	372	3.6	120	536	8.5	38	420	1879	0	0	Fe ₂ -0.5
	8-2-73	89	3.4	110	119	6.0	6	460	496	0	0	Fe ₂ -2.7
	9-7-73	103	3.6	76	94	4.6	6	410	508	0	0	Fe ₂ -1.0
	10-19-73	89	3.5	84	91	4.3	5	349	376	0	0	
	11-25-73	466	3.9	34	191	2.0	11	226	1267	0	0	
	12-9-73	418	3.7	82	412	14.7	74	225	1132	0	0	
	12-28-73	1915	2.9	80	1840	9.1	211	325	7474	0	0	Fe ₂ -4.5
	1-26-74	2335	3.2	100	2803	13.0	364	150	4205	0	0	Fe ₂ -5.6
	2-16-74	867	3.2	10	104	13.0	135	175	1820	0	0	Fe ₂ -5.6
	3-23-74	2205	3.5	84	2223	10.0	265	200	5294	0	0	

Stream to Unnamed
Kyler Run

Average 893 3.4 83 803 8.3 104 325 2851 Fe₂-3.3 11

V. APPENDIX

A. SAMPLING PROGRAM RESULTS

Test Point No.	Date	Flow GPM	pH	Acidity		Total Iron		Sulfates		Alkalinity		Other PPM
				PPM	lb/day	PPM	lb/day	PPM	lb/day	PPM	lb/day	
101	5-31-73	5567	3.3	120	8022	3.2	214	420	28076	0		
	6-26-73	902	3.4	130	1408	8.7	94	590	6393	0		
	7-13-73	2033	3.4	170	4151	9.5	232	420	10257	0		
	8-2-73	502	3.1	180	1087	8.0	48	440	2657	0		
	9-7-73	1257	3.2	210	3170	10.0	151	530	8000	0		
	10-19-73	835	3.3	180	1805	9.4	94	426	4272	0		
	11-25-73		3.5			36.7		150		0		
	12-14-73	6824	3.3	120	9833	8.1	663	445	36464	0		
	12-28-73	12931	3.4	164	25462	11.8	1838	355	55118	0		
	1-26-74	8591	3.4	124	12790	9.0	928	225	23208	0		
	2-16-74	6286	3.2	12	905	12.9		275	20755	0		
	3-23-74	5029	3.6	102	6159	7.6	456	150	9057	0		
	Average	4614	3.4	130	6799	11.2	471	368	18568			
103	6-4-73		4.1	24		0.4		190		0		
	6-27-73	13	4.1	54	9	1.1	0.2	220	36	0		
	6-13-73	9	4.0	46	5	1.0	0.1	230	25	0		
	8-2-73	3	3.6	72	3	0.9		290	11	0		
	9-7-73	3	3.6	96	4	0.8	.03	320	14	0		
	10-19-73	2	3.7	72	2	2.9	.07	248	6	0		
	11-25-73	2	3.4	50	2	.15	.01	151	5	0		
	12-9-73	26	3.8	44	14	.44	.14	165	53	0		
	12-28-73	80	5.6	4	4	.438	.43	85	82	0		
	1-26-74	157	6.6	8	15	.146	.28	85	160	0		
	2-16-74	101	4.5	20	24	.741	.90	175	213	0		
	3-23-74	305	4.8	18	66	.444	2.0	170	623	0		
	Average	64	4.3	42	13	0.78	.39	194	112			

Point on Little Toby Creek @ Kyler's Corner
 Kyler Mine Stripping Outflow to Kyler Run

V. APPENDIX

A. SAMPLING PROGRAM RESULTS

Test Point No.	Date	Flow GPM	pH	Acidity		Total Iron		Sulfates		Alkalinity		Other	
				PPM	lb/day	PPM	lb/day	PPM	lb/day	PPM	lb/day	PPM	lb/day
104	6-4-73		3.5	100	4.2	470	0						
	6-27-71	395	3.4	110	36.0	480	0	2277					
	7-12-73	224	3.4	110	38.0	480	0	1294					
	8-2-73	121	3.1	120	32.0	500	0	728				Fe ₂ -18.0	48
	9-7-73	125	3.4	160	42.0	520	0	785				Fe ₂ -27.0	39
	10-19-73	121	3.2	140	30.0	348	0	507				Fe ₂ -28.0	42
	11-25-73	130	3.4	46	29.4	200	0	313				Fe ₂ - 6.7	10
	12-13-73	396	3.1	134	25.3	390	0	1858				Fe ₂ - 9.0	14
	12-28-73	170	3.4	76	26.1	225	0	461				Fe ₂ -19.0	90
	1-26-74	180	3.6	62	9.7	390	0	841				Fe ₂ -10.0	20
	2-16-74	651	3.4	68	14.3	325	0	2540				Fe ₂ - 5.6	12
	3-23-74	166	4.7	32	7.1	325	0	648				Fe ₂ - 5.6	44
												Fe ₂ - 1.1	2

29

107	Average	243	3.5	97	24.5	388	0	1114				Fe ₂ -13.0	32
	6-23-73	3138	3.2	220	88	840	0	31654				Fe ₂ - 1.0	28
	7-13-73	2294	3.3	230	76	840	0	23140				Fe ₂ - 91.0	1153
	8-2-73	1055	2.9	320	110	970	0	12289				Fe ₂ -100.0	1638
	9-7-73	1364	3.2	380	130	1000	0	16389				Fe ₂ - 70.6	1279
	10-19-73	1508	2.9	420	99	597	0	10814				Fe ₂ - 19.5	369
	11-25-73	1575	3.0	54	78.5	850	0	16084				Fe ₂ - 44.8	669
	12-14-73	1243	2.9	400	48.3	1020	0	15231				Fe ₂ - 66.0	1025
	12-28-73	1293	3.0	200	85.1	925	0	14362				Fe ₂ - 30.2	567
	1-26-74	2492	6.3	8	.3	45	0	1346				Fe ₂ - 26.9	650
	2-16-74	1563	3.2	178	40.5	400	0	7504					
	3-23-84	2012	4.0	206	27.3	450	0	10868					

	Average	1776	3.5	238	71.2	722	0	14517				Fe ₂ - 50.0	820
--	---------	------	-----	-----	------	-----	---	-------	--	--	--	------------------------	-----

Kyler Mine to Hays Run

V. APPENDIX

A. SAMPLING PROGRAM RESULTS

Test Point No.	Date	Flow GPM	pH	Acidity		Total Iron		Sulfates		Alkalinity		Other PPM
				PPM	lb/day	PPM	lb/day	PPM	lb/day	PPM	lb/day	
112	6-26-73	76	3.0	340	311	50	49	610	559	0	0	Al-24
	7-13-73	9	3.1	380	41	44	5	680	73	0	0	Ca-108
	8-2-73	6	2.7	400	32	50	4	750	61	0	0	Fe ₂ -0.5
	9-7-73	3	2.8	420	18	60	3	830	36	0	0	Fe ₂ -8.4
	10-19-73	1	2.8	560	9	46	1	798	13	0	0	Fe ₂ -0.8
	11-25-73	12	2.8	340	49	36.7	5	650	95	0	0	Fe ₂ -6.7
	12-13-73	282	2.8	600	2037	30.7	104	700	2377	0	0	---
	12-28-73	143	2.9	300	518	44.7	77	425	733	0	0	Fe ₂ -6.7
	1-26-74	144	3.0	326	562	33.4	58	450	776	0	0	Fe ₂ -4.5
	2-16-74	30	2.9	340	123	38	14	400	145	0	0	Fe ₂ -4.5
	3-23-74	139	3.3	282	471	28	47	400	668	0	0	Fe ₂ -2.2
Average		77	2.9	390	379	42.0	33	609	503			Fe ₂ -4.3

3

Note: Al determined by AA method 129 standard method 13th edition
 Ca determined by AA EPA method 203A standard method 13th edition

113	7-12-73	9	3.7	76	12	8.0	0.8	310	33	0	0	
	8-2-73	11	3.3	80	11	9.0	1.2	380	53	0	0	
	9-7-73	4	3.4	82	4	26.0	1.4	320	17	0	0	
	10-19-73	9	3.2	100	100	11	1.2	326	35	0	0	
	11-25-73	39	5.7	44	20	3.2	1.5	176	83	24	11	
	12-13-73	10	5.4	50	6.4	4.3	.6	215	27	18	2.3	
	12-28-73	24	3.4	40	11.6	3.77	1.1	275	80	0	0	
	1-26-74	72	5.5	32	28	.44	.4	195	168	0	0	
	2-16-74	27	3.7	94	30	3.9	1.2	225	72	0	0	
	3-23-74	211	5.1	24	61	3.3	8.3	305	773	0	0	
Average		42	4.2	62	20	7.3	1.9	273	134	21	6.6	

Dagus Mine Caved Heading to Dagus Mine Caved Heading to

V. APPENDIX

A. SAMPLING PROGRAM RESULTS

Test Point No.	Date	Flow GPM	pH	Acidity		Total Iron		Sulfates		Alkalinity		Other PPM
				PPM	lb/day	PPM	lb/day	PPM	lb/day	PPM	lb/day	
121	7-12-73	9	3.6	100	11	3.7	0.4	380	41	0	0	
	8-2-73	2	3.2	110	3	4.1	0.1	120	3	0	0	
	9-7-73	1	3.4	120	1	5.7	0.1	380	4	0	0	
	10-19-73	5	3.5	102	6	3.4	0.2	274	16	0	0	
	11-25-73	987	3.8	56	664	2.5	29.6	225	2669	0	0	
	12-13-73	32	3.8	60	23	1.4	0.5	260	100.9	0	0	
	12-28-73	155	4.1	22	41	.7	1.4	205	383	0	0	
	1-26-74	215	4.6	22	57	.6	2.0	285	737	0	0	
	2-16-74	505	3.7	70	424	1.5		225	1364	0	0	
	3-23-74	525	4.1	114	719	.9	6.0	450	2838	0	0	

Unnamed Stream From Smiths
Rogos Stripping

Average	244	3.8	78	195	2.5	4.0	280	816				
9-7-73	1885	3.1	240	5434	23.0	521	600	13585	0	0	0	
10-19-73	1194	3.1	220	3155	38.0	545	349	5005	0	0	0	
11-25-73												
12-14-73	5118	3.1	140	8604	15.6	958	410	25197	0	0	0	
12-28-73	18332	3.4	122	26853	13.2	2906	310	68236	0	0	0	
1-26-74	9770	3.2	122	14312	10.6	1243	200	23462	0	0	0	
2-16-74	6941	3.2	138	11501	12.8	1066	250	20836	0	0	0	
3-23-74	5370	3.7	96	6190	8.7	558	275	17731	0	0	0	

Point on Little Toby Creek Below
Hays Run Outflow

Average	6944	3.3	154	10864	17.4	1114	342	24864				
---------	------	-----	-----	-------	------	------	-----	-------	--	--	--	--

2. Special Test Stations

In addition to the regular test stations, investigations were made at numerous other points to more accurately pinpoint problem areas and to clarify questions that had arisen from past results. A summary of these results are enumerated hereunder:

(a) From this form of testing it was learned that the flows on the western side of the Cartwright Mine were acidic in some locations and alkaline in others.

(b) Sample results from points #62, an outlet to a surface mine pond, and #131 a point up stream from discharge of pond, indicated that after the

<u>Test Point</u>	<u>Date</u>	<u>Flow</u>		<u>Acidity</u>		<u>Total Iron</u>		<u>Sulfates</u>		<u>Alkalinity</u>		<u>Other</u>
		<u>GPM</u>	<u>pH</u>	<u>PPM</u>	<u>#/Day</u>	<u>PPM</u>	<u>#/day</u>	<u>PPM</u>	<u>lb/day</u>	<u>PPM</u>	<u>lb/Day</u>	
3	8-22-73	1	2.7	220	1.2	28	0.2	310	1.7	---	---	
14	8-22-73	1	7.0	---	---	6	0.1	160	1.7	110	1.2	
15	8-22-73	1	2.5	7.30	7.8	110	1.2	830	8.9	---	---	
16	8-22-73	2	2.8	220	4.7	73	1.5	520	11.2	---	---	
17	8-22-73	11	6.8	---	---	4	0.6	470	63.3	170	22.9	
143	8-22-73	27	7.7	---	---	5	1.4	540	174.7	150	48.5	

ponding and liming, the water quality was poorer than the stream coming directly through the stripping spoil. These points are on the head waters of Little Toby Creek due east of Coal Hollow.

<u>Test Point</u>	<u>Date</u>	<u>Flow</u>		<u>Acidity</u>		<u>Total Iron</u>		<u>Sulfates</u>		<u>Alkalinity</u>		<u>Othe</u>
		<u>GPM</u>	<u>pH</u>	<u>PPM</u>	<u>#/Day</u>	<u>PPM</u>	<u>#/day</u>	<u>PPM</u>	<u>lb/day</u>	<u>PPM</u>	<u>lb/day</u>	
62	8-22-73	31	3.7	79	29.8	9	3.4	430	162.3	---	---	
131	8-21-73	34	3.5	51	20.6	2	0.6	130	52.6	---	---	

(c) Water being emitted from air seals along the old road from Toby to Coal Hollow varied considerably in quality in that two points, (79, 80) were found to be alkaline and have tolerable sulfate quantities while the other seals were emitting acid water with wide ranges of sulfates. Iron contents were fairly constant.

Test Point	Date	Flow		Acidity		Total Iron		Sulfates		Alkalinity		Other
		GPM	pH	PPM	lb/day	PPM	#/day	PPM	lb/day	PPM	lb/day	
65	3-23-74	135	4.9	46	74	59	97.0	225	364	---	---	
79	8-24-73	---	6.5	--	--	2.8		290		10		
80	8-24-73	6	7.5	--	--	5.1	0.4	24	1.7	73	5.1	
80	9-7-73	1	7.8	--	--	0.1	---	29	0.3	84	0.9	
84	8-24-73	1	2.9	270	2.9	7.1	0.1	520	5.6	---	---	
84	9-7-73	---	3.0	240	--	7.2	---	500	---	---	---	
84	10-19-73	1	3.0	264	0.1	8.6	0.0	524	0.1	---	---	

(d) Water from the Ticossi Mine in the Middle Kittanning Coal is alkaline, the same as water from the Eureka #2 Mine (#97). The sulfate and iron content however is higher at Ticossi.

Test Point	Date	Flow		Acidity		Total Iron		Sulfates		Alkalinity		Other
		GPM	pH	PPM	lb/day	PPM	#/day	PPM	lb/day	PPM	lb/day	
122	8-22-73	4	7.6	---	---	3.1	0.2	150	8.1	120	6.5	

(e) The dilution of the mine water surfacing at point #113 in the Limestone Run area by an alkaline spring with acceptable iron and sulfate quantities located downstream is effective in improving water quality.

Test Point	Date	Flow		Acidity		Total Iron		Sulfates		Alkalinity		Other
		GPM	pH	PPM	lb/day	PPM	#/day	PPM	lb/day	PPM	lb/day	
132	8-21-73	11	6.6	--	--	0.6	0.1	2.0	7.9	2.2	3.0	
133	8-21-73	13	6.0	15	2.4	0.9	0.1	170	275	---	---	
113	8-2-73	11	3.3	80	11	9.0	1.2	380	53	---	---	
113	9-7-73	4	3.4	82	4	26.0	1.4	320	17	---	---	

(f) Water delivered to a home from the Dagus Mine Water Supply, located near reference point 90 was analyzed and found to have a pH of 6.1 and acid content of 4 ppm. A water sample taken from a gas station receiving water from the Kyler Run Reservoir was also analyzed and found to be a higher quality water as alkalinity was tested at 2 ppm, iron at 0.5 ppm and sulfates at 5 ppm. The pH was 6.7. Sample numbers were 134 and 135.

(g) Sampling of Hays Run at reference point 139 above the Kyler Mine water course at point #107 indicates that the mine is the source of pollution on this stream.

Test Point	Date	Flow		Acidity		Total Iron		Sulfates		Alkalinity		Other
		GPM	pH	PPM	lb/day	PPM	#/day	PPM	lb/day	PPM	lb/day	
139	8-22-73	6.4		---	---	1.9	0.9	62	30.1	---	---	

(h) The effect of seepage through old mine refuse located on the western bank of Little Toby Creek was determined by analyzing water from pools located above and below a refuse pile located on Little Toby Creek. The water in the lower pool coming from seepage through the refuse. In this case the pH went from 3.4 to 2.6 while the acidity went from 92 to 360 ppm. Iron content rose from 4 to 72 while sulfate went from 380 to 590. See analysis results for points 141 and 142 on page 35 .

(i) Results of water analysis from other points are tabulated hereunder.

Test Point	Date	Flow		Acidity		Total Iron		Sulfates		Alkalinity		Location
		GPM	pH	PPM	lb/day	PPM	#/day	PPM	lb/day	PPM	lb/day	
90	8-22-73	22	3.0	160	43.1	17	4.6	490	132.1	---	---	Air Seal-Dagus Mine
106	8-22-73	1	2.4	640	6.9	110	1.2	660	7.1	---	---	Air Seal-Kyler Mine
111	8-24-73	---	6.7	---	---	1.5	---	19	---	10	---	Spring Disgs.
125	8-22-73	---	6.7	---	---	0.8	---	14	---	9	---	Pond discharge Daguscahonda Run
136	8-24-73	6	2.8	310	21.7	36	2.5	820	57.5	---	---	Caved Drift-Toby Mine
138	8-24-73	---	5.9	6	---	1.5	---	31	---	---	---	Spring Disgs.
140	8-24-73	---	3.0	150	---	8.0	---	400	---	---	---	Pond
144	8-24-73	22	3.4	78	302.7	3.9	15.1	360	1397.3	---	---	Little Toby Cr.
149	2-16-74	---	5.7	82	1708	10.3	214	225	4686	---	---	Kyler Run
150	2-16-74	1795	3.6	64	1380	4.2	89	275	5930	---	---	Little Toby Cr.
151	2-16-74	13	6.0	10	2	0.9	0.1	300	48	---	---	Swamp Disgs.
98	10-19-73	---	3.0	200	---	26.1	---	524	---	---	---	Unnamed Stream to Kyler Run
98	2-16-74	---	3.0	140	---	27.2	---	425	---	---	---	Pond along Unnamed Stream
49	9-7-73	---	6.8	10	0.5	1.1	0.05	680	33	---	---	Spring Disgs.
117	9-7-73	4	3.0	1100	47	20	0.9	2100	91	---	---	Discharge from Surface Mine

B. Subsurface Exploration Program

1. SL 132-5 Project Area

In order to properly evaluate proposed reclamation measures and ascertain the validity of the mine map information utilized for the preparation of this plan a subsurface exploration program was undertaken. The results of this program are included herein. The tabulation on pages 62 through 73 briefly describes the findings at each hole and summarizes the results of the drilling and pressure testing within the project area. The drill logs have been plotted and are also presented herein. Their locations are found on Plate 19.

An investigation and determination of property owners was made during the subsurface exploration program. Information obtained was presented to DER in reproducible form at that time.

2. SL 132-1 Project Area

In order to obtain more data to assist in the evaluation of information provided to DER in the Toby Creek SL 132 -1 Report five test holes were drilled in the Brandy Camp Creek to Hays Run Area. Of these five, three were cored and two drilled with an air rotary rig.

From the information; provided by drilling these five holes, we have concluded that the Lower Kittanning seam has been mined out as shown, but there are major variances in the contours. There was no evidence of mining in the Middle Kittanning seam except in drill hole KK which means holes II, JJ and LL all hit pillars of coal remaining in the mined out area or mining in this seam was not as extensive as shown. The elevations of this seam found by drilling conformed with those shown on Drawing A4. Drill hole EE hit a barrier as anticipated. The Freeport Limestone depicted on Drawing A5 does exist throughout this area as shown. A brief analysis of these holes is found on page 74.

The drill hole locations are found on Plate 6, while logs are found on Plates 16 and 17.

The following tabulation and drill hole logs summarizes the results of the drilling and pressure testing conducted within the project area.

<u>Drill Hole No.</u>	<u>Type</u>	<u>Comments</u>
A	Core Boring	Lower Kittanning coal barrier was found intact. Minimal amounts of grout would be required above and below the coal seam; however, the seam itself was found to be quite permeable.
B	Core Boring	Mine void was encountered in Lower Kittanning coal seam. This was considered to be the heading shown on the mine map. Apparently the outflow of water was restricted since the 24 hour reading indicated that the water level was above the roof of the mine. Grout requirements 28 feet above the void are minimal.
C	Core Boring	Lower Kittanning coal barrier was found intact. Heavy grouting required below, in and above coal seam.
D	Core Boring	Lower Kittanning Coal barrier was encountered. Grouting considered unnecessary. 24 hour water level was above coal seam.
E	Core Boring	Lower Kittanning coal seam was found intact. Heavy grouting could be required below, in and 8 feet above coal seam.
E-1	Core Boring	Mine void found in Lower Kittanning seam assumed to be mine opening shows on mine map. Mine roof was found to be very solid thereby eliminating the need for grouting.
F	Core Boring	Lower Kittanning coal barrier was found intact. Heavy grouting could be required above and below the coal seam. The coal seam itself and the strata immediately above it was found to be impervious.
G	Rotary	The Lower Kittanning coal seam was found signifying that a stump in the mine had been encountered. A monitor well was installed.


<u>Drill Hole No.</u>	<u>Type</u>	<u>Comments</u>
H	Rotary	The Lower Kittanning coal seam was encountered and found in tact. This site would be suitable for discharge.
I	Rotary	A mine void in the Lower Kittanning coal seam was found. This site would be more suitable for a discharge point than the location "H" since the coal seam is 3 feet lower and has been removed.
J	Core Boring	The Middle Kittanning coal was found intact The mine in the Lower Kittanning coal seam was caved with some subsidence occurring above the mine. Medium amounts of grout would be required for sealing. Seven feet of limestone(considered Vanport) was found 45 feet below the mine floor.
K	Core Boring	Mine void found in Lower Kittanning seam. - The mine roof was found to be solid. A mine water stand pipe was installed.
L	Core Boring	The Lower Kittanning coal seam was found to be intact and solid. Weathered shale immediately above the coal would accept minor amounts of grout.
M	Core Boring	A mine void was found in the Lower Kittanning coal seam. The roof was solid and would be suitable for sealing. Medium amounts of grout would be required after the first five feet of roof
N	Core Boring	The Lower Kittanning Coal Seam was found to be intact but quite pervious. Immediately above and below the seam the strata was impervious.
N-1	Core Boring	A mine void was found in the Lower Kittanning coal seam, indicating that the mine entrance shown on the map had been drilled through. The roof was found to be solid and impervious making it suitable for sealing.
N-2	Core Boring	The Lower Kittanning coal seam was found intact but very pervious thereby requiring large amounts of grout if seepage is to be curtailed. The strata above is solid.

<u>Drill Hole No.</u>	<u>Type</u>	<u>Comments</u>
N-3	Core Boring	The Lower Kittanning coal seam was encountered. Medium amounts of grout would be required to seal the seam but the roof was found to be impervious for approximately six feet above the coal seam.
N-4	Core Boring	The Lower Kittanning coal seam was encountered. No pressure testing was performed.
N-5	Core Boring.	A mine void was found at this location indicating that the mine opening shown on the map had been located. The roof was solid and impervious making it suitable for sealing. Medium amounts of grout would be required to seal strata laying five feet above the mine roof.
0	Core Boring	The Lower Kittanning coal seam was encountered and found to be impervious. The strata above the mine was also found to be relatively impermeable during pressure testing.
0-1	Core Boring	22 feet of Lower Kittanning coal was found in this drill hole. The strata below, in and above the coal was found to be quite pervious which accounts for the numerous seeps along the coal outcrop line. Limestone was found to be 52 feet thick 54feet under the coal.
P	Rotary	A void was encountered as expected in the mine opening at the Lower Kittanning coal seam horizon. This point would be suitable for a discharge structure.
Q	Core Boring	A barrier was hit in the Lower Kittanning coal seam. No pressure testing was conducted.
R	Core Boring	The Lower Kittanning coal seam was encountered and found to be porous enough to require medium amounts of grout for complete sealing.
R-1	Core Boring	The Lower Kittanning Coal seam located in this hole was quite impervious. Three feet of Limestone was found 50 feet below the coal.
R-2	Core Boring	The Lower Kittanning coal seam encountered was porous indicating medium amounts of grout would be required.

<u>Drill Hole No.</u>	<u>Type</u>	<u>Comments</u>
R-3	Core Boring	A mine void was hit at the Lower Kittanning coal seam. Pressure testing indicated that a heavy grout with additives would be needed to form an impervious roof if sealed at this point.
T	Rotary	The Middle Kittanning coal seam was found intact and a void was hit as anticipated at the Lower Kittanning coal seam elevations. The roof was intact. A monitor well was installed.
V	Rotary	Only 14 feet of spoil was encountered after which undisturbed overburden was found which meant that the Lower Kittanning coal seam was not removed by surface mining at this location.
W	Rotary	Undisturbed overburden was found under 16 feet of spoil at this point. Forty nine feet lower a mine void was found in Lower Kittanning coal horizon. Surface mining would have been in the Middle Kittanning at this location.
X	Rotary	Forty feet of overburden was found above a three foot seam of fire clay commonly found under the Lower Kittanning coal. It was therefore concluded that the Lower Kittanning coal seam had been removed by surface mining.
Y	Rotary	Only nine feet of spoil was found here before undisturbed shale was encountered. Fifty eight feet above the clay found in Hole X. This indicated that the Middle Kittanning seam had been removed by surface mining operations.
Z	Rotary	Eighteen feet of spoil was found before undisturbed earth was encountered. This indicates that the Lower Kittanning coal had been removed in its entirety along the crop line.
AA	Rotary	Only thirteen feet of spoil was found before undisturbed overburden was encountered. The elevation indicates that the mine map was correct in showing the rise of the Lower Kittanning coal seam.

<u>Drill Hole No.</u>	<u>Type</u>	<u>Comments</u>
FF	Rotary	A mine void was encountered at an elevation of 1718. This would place the mining activities in the Middle Kittanning seam or the Enos Hays Mine. A monitor well was installed.
FF-1	Rotary	This hole was drilled over two hundred feet west of FF in an effort to miss the Enos Hays Mine. However the Middle Kittanning seam had been removed at this location indicating that the mine map utilized in planning did not depict the extent of this mining operation. Due to the consistency found in the elevation difference between the Lower Kittanning and the Middle Kittanning seam the drilling was not continued into the Lower Kittanning seam.
MM	Core Boring	A mine void was hit at the Lower Kittanning Coal seam elevation. The roof was found to be solid and impervious which would be satisfactory for sealing.
NN	Core Boring	The Lower Kittanning coal seam was encountered and found to be impervious as was the strata directly above. The underlying strata was less dense and would require grout for sealing.
NN-1	Core Boring	The Lower Kittanning coal seam was found in tact. Pressure tests indicated that the strata was very dense and would not require grout if sealed and flooded.
PP	Core Boring	The bottom of a void in the Cartwright Mine was found at an elevation of 1711.58 approximately 52 feet below a 22 foot seam of un-mined Middle Kittanning coal. These elevations verified previous field work and mapping.
QQ	Core Boring	A mine void was encountered in the Lower Kittanning coal seam verifying the mine map data in this area.

<u>Drill Hole No.</u>	<u>Type</u>	<u>Comments</u>
EE	Core Boring	The first coal seam encountered at an elevation of 1713.42 was considered as the Middle Kittanning seam which placed the Lower Kittanning at 1666.42. Both seams were intact which placed the hole outside the periphery of this mine. The Lower Kittanning coal elevation compare favorably with mine map contours.
II	Core Boring	A mine void was encountered in the Lower Kittanning coal seam with a bottom elevation of 1616 which places it approximately 20 feet lower than mine map contours. The Middle Kittanning seam was intact at an elevation of 1666 which is approximately ten feet lower than the mine map contours at this location. A 7.1 foot seam of Freeport Limestone was found at 1737.
JJ	Rotary	The Lower Kittanning coal seam was encountered at an elevation of 1599 which placed the Middle Kittanning at 1653. The Middle Kittanning is in agreement with the report map but the Lower Kittanning varies by 60 feet. Although recorded differently in the field we believe the strata from 1720 to 1727 is Freeport Limestone.
KK	Rotary	A mine void was encountered in the Middle Kittanning coal seam at an elevation of 1686. This indicates that the Middle Kittanning drawing in the report is fairly accurate. We interpret the 12 foot seam found from 1747 to 1759 as including Freeport Limestone.
LL		The mine void encountered at this location was in the Lower Kittanning seam. The Middle Kittanning seam was intact. The Lower Kittanning lies at 1620.17 which agrees Fully with the mine map contours. The Middle Kittanning was found to be 10 feet lower than shown on the drawing.

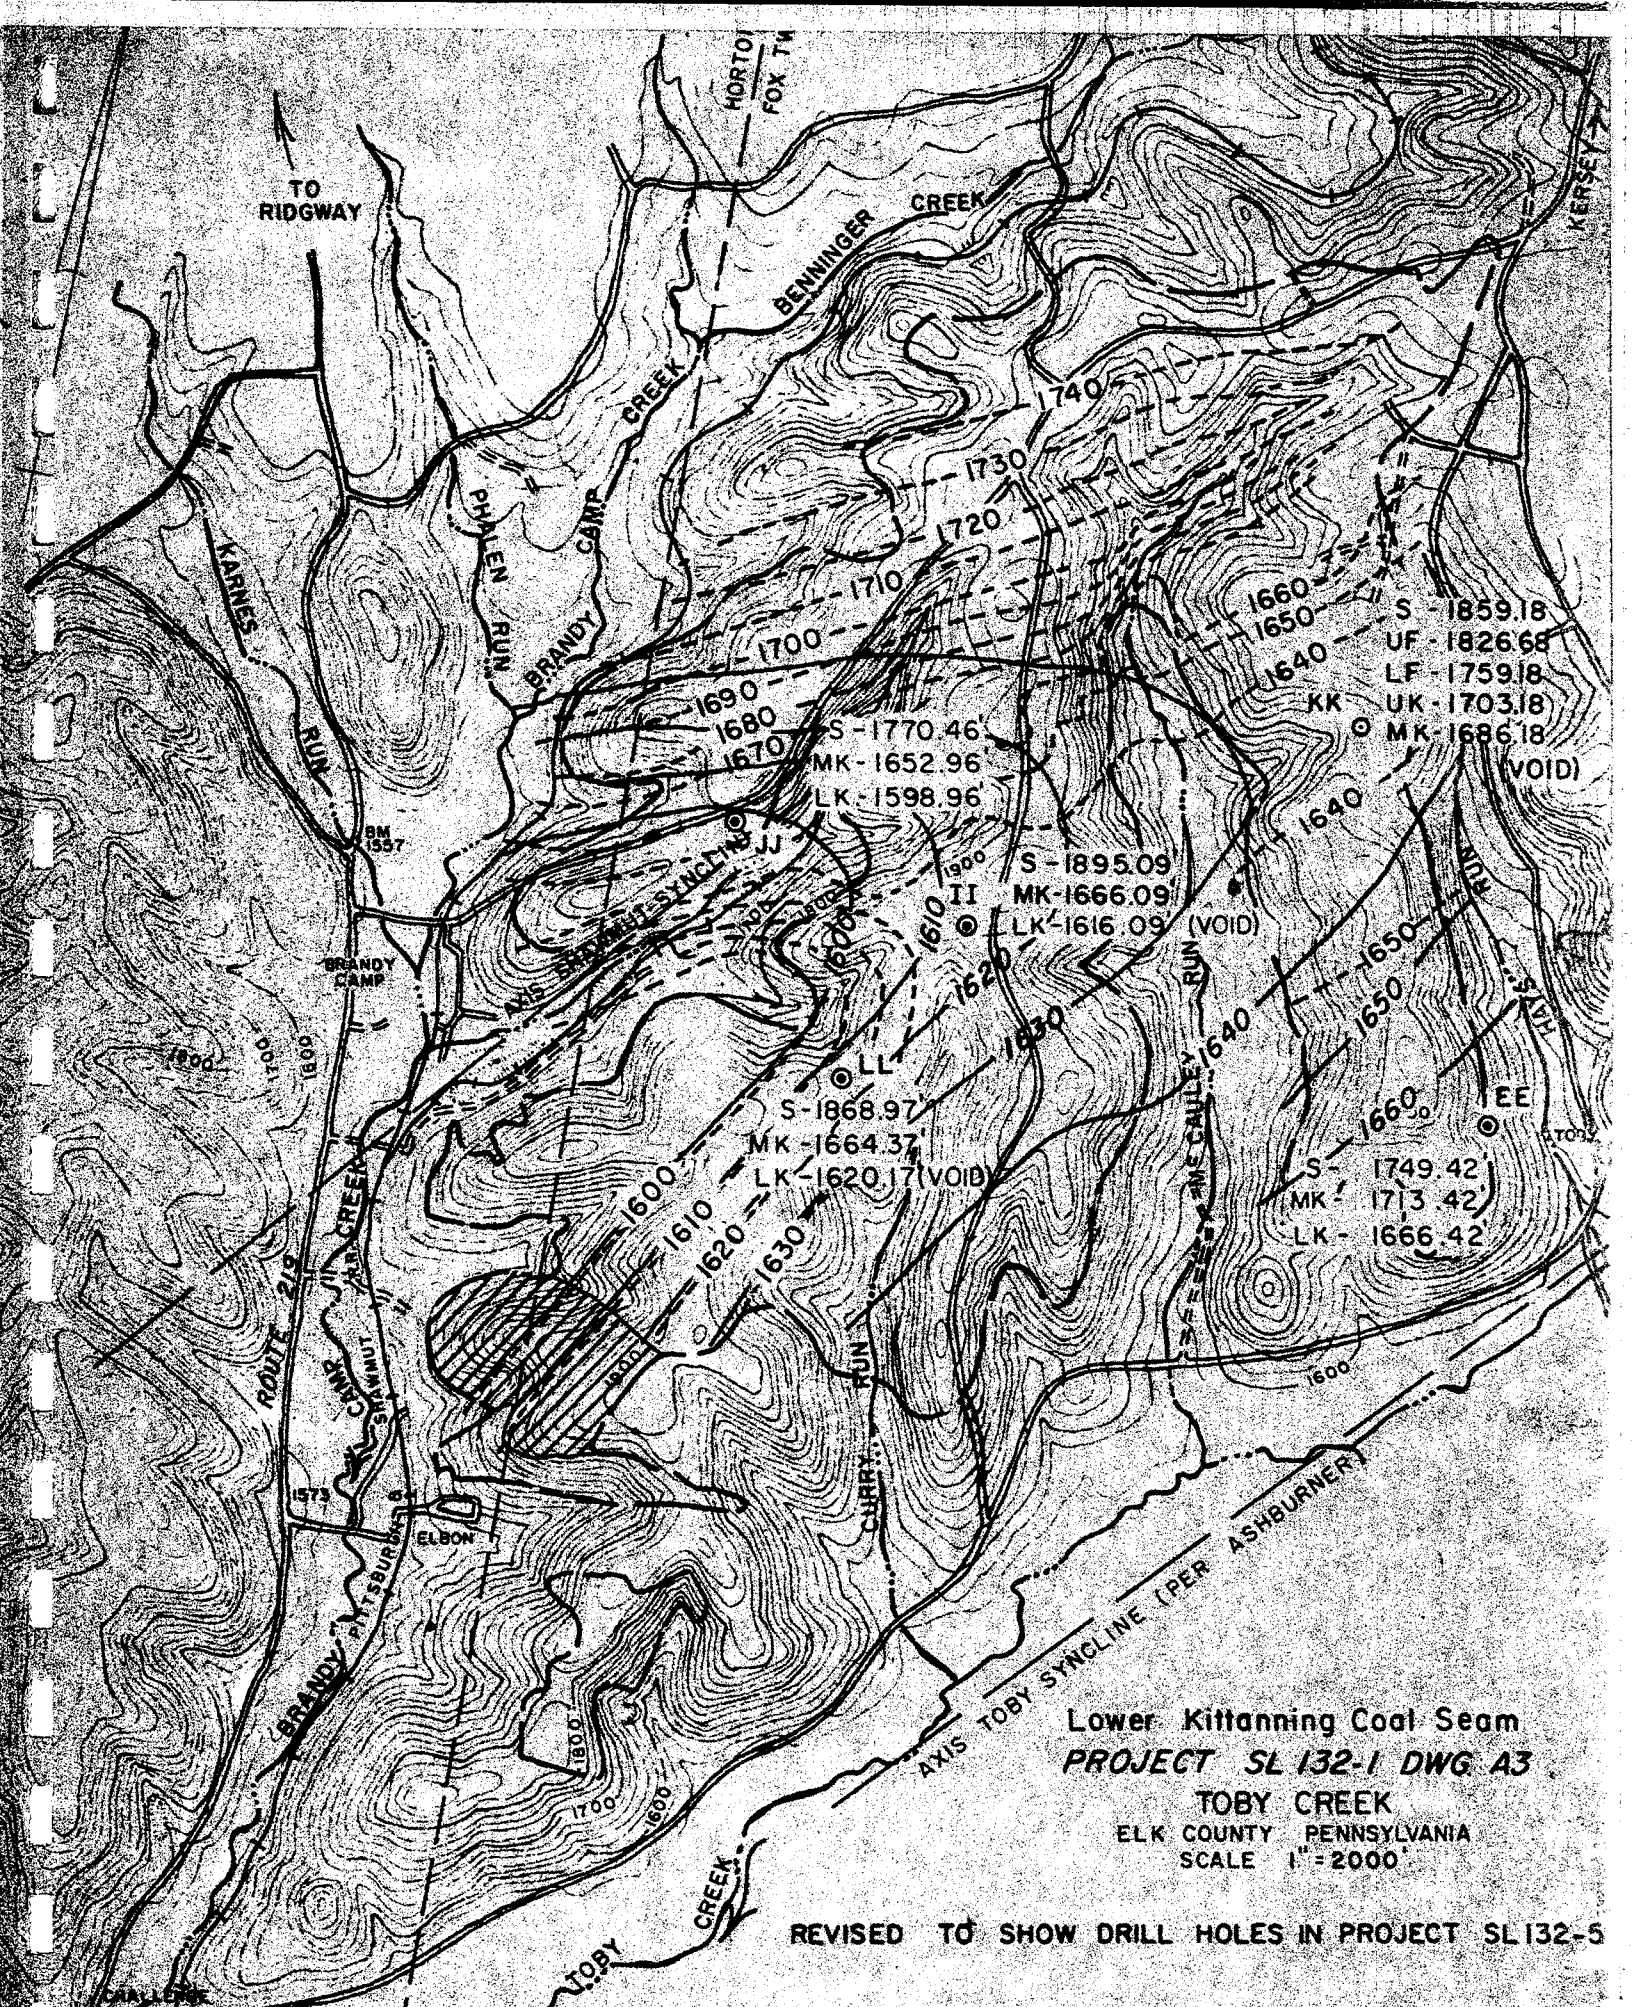


Lower Kittanning Coal Seam
PROJECT SL 132-1 DWG A3
TOBY CREEK
 ELK COUNTY PENNSYLVANIA
 SCALE 1" = 200'


REVISED TO SHOW DRILL HOLES IN PROJECT SL132-5

CONTOURS FROM SUBSURFACE EXPLORATION
 CONTOURS FROM MINE FLOOR ELEVATIONS
 PRESUMED LOCATION OF MINES - NO RECORDS AVAILABLE


PLATE 6

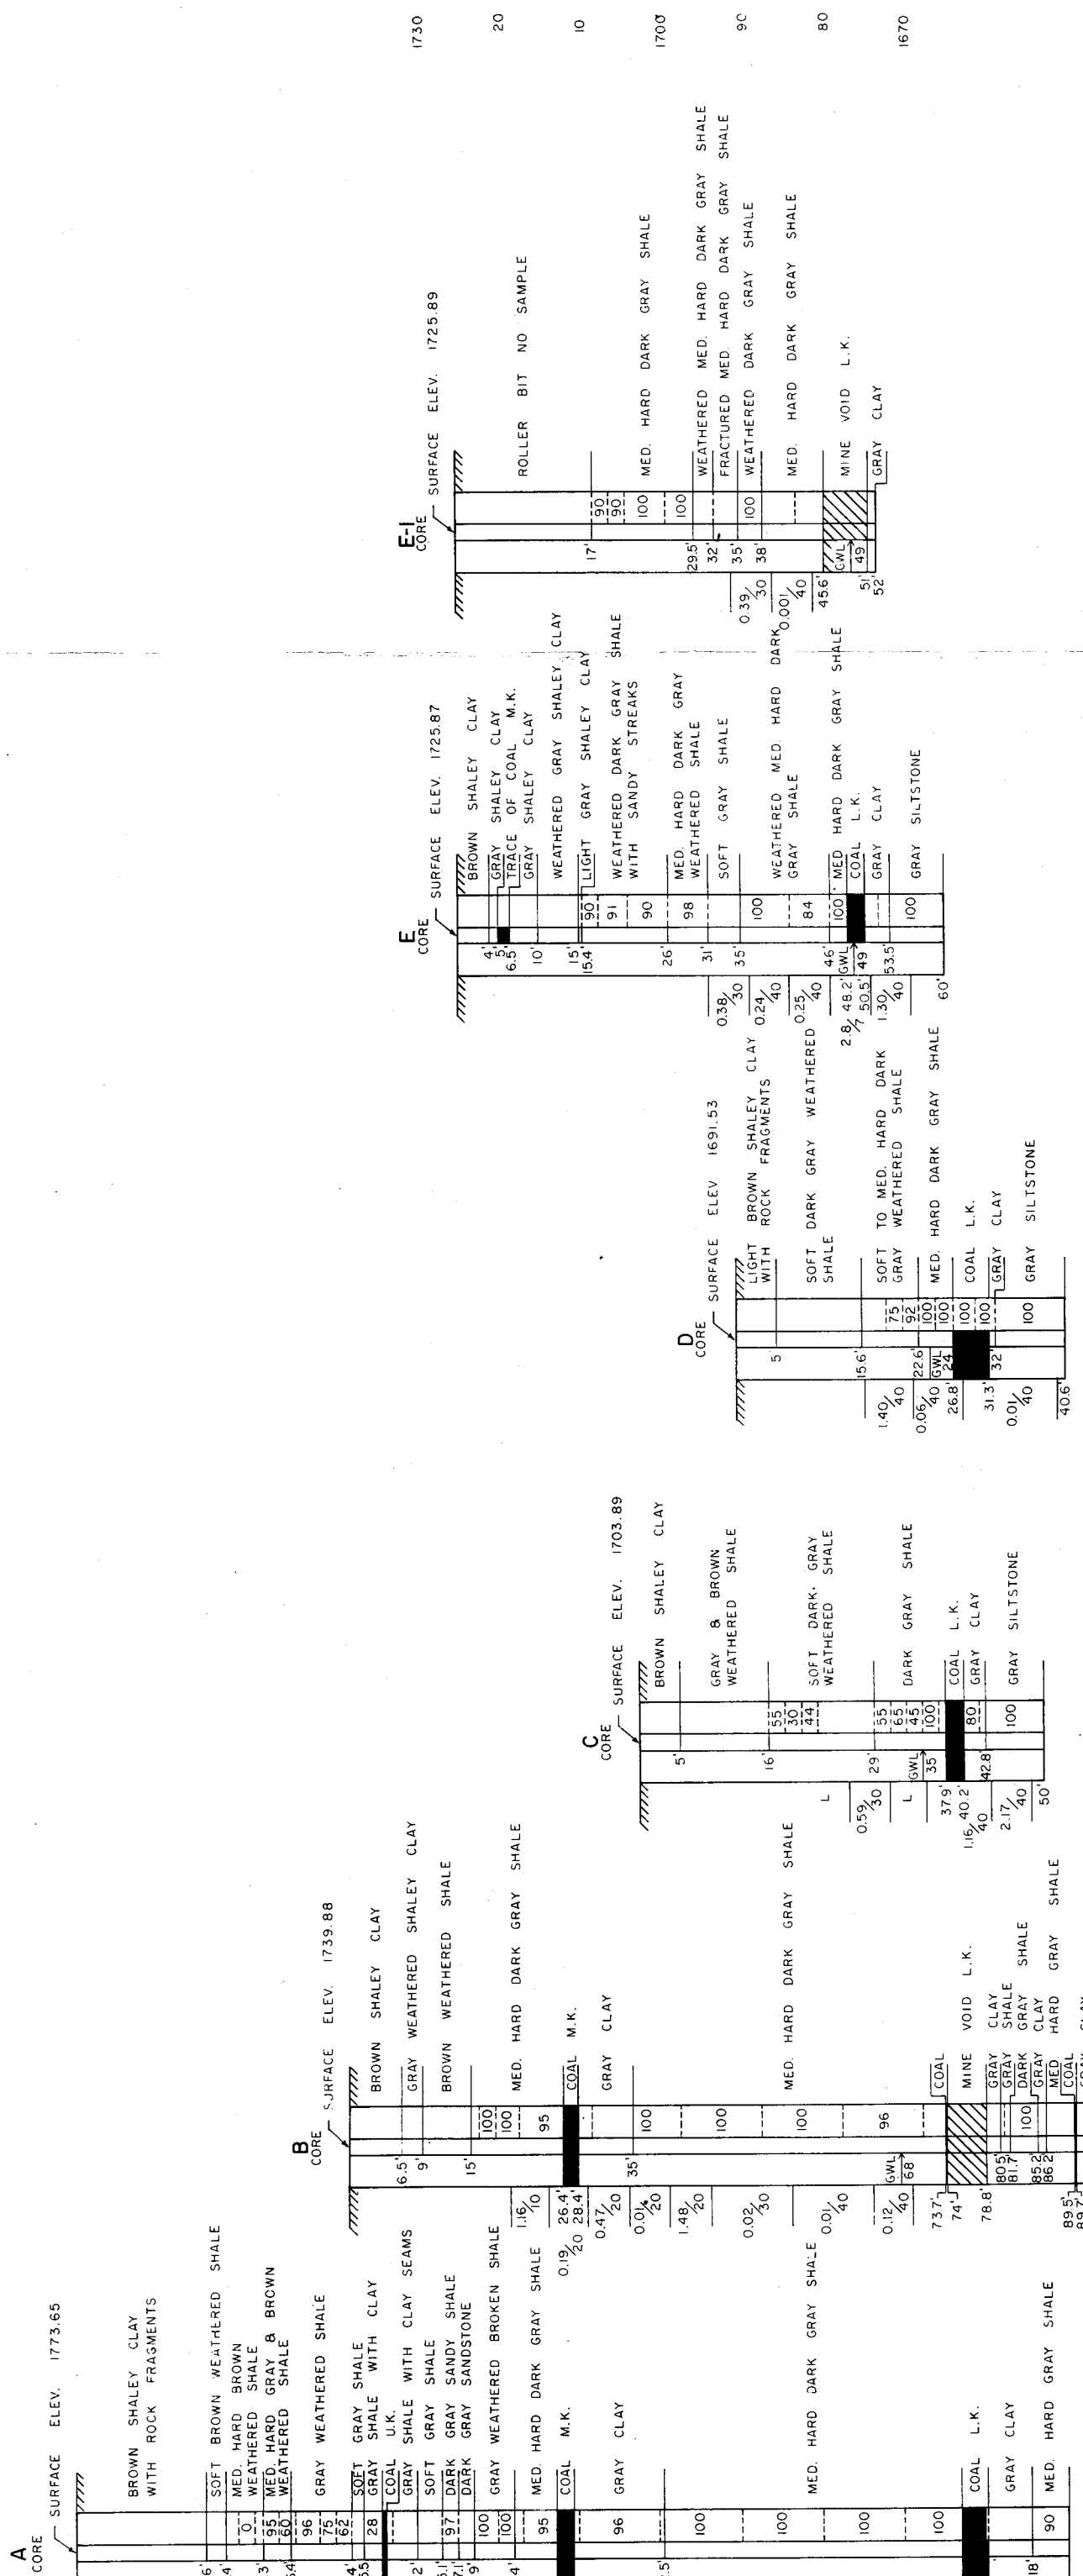


DEPARTMENT OF ENVIRONMENTAL RESOURCES
 PROJECT SL 132-5-101.5
 LITTLE TOBY CREEK
 ELK COUNTY
 SUBSURFACE EXPLORATION
 BORE HOLES
 A, B, C, D, E, E-I

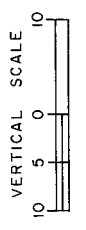


G (1931.10-1750)

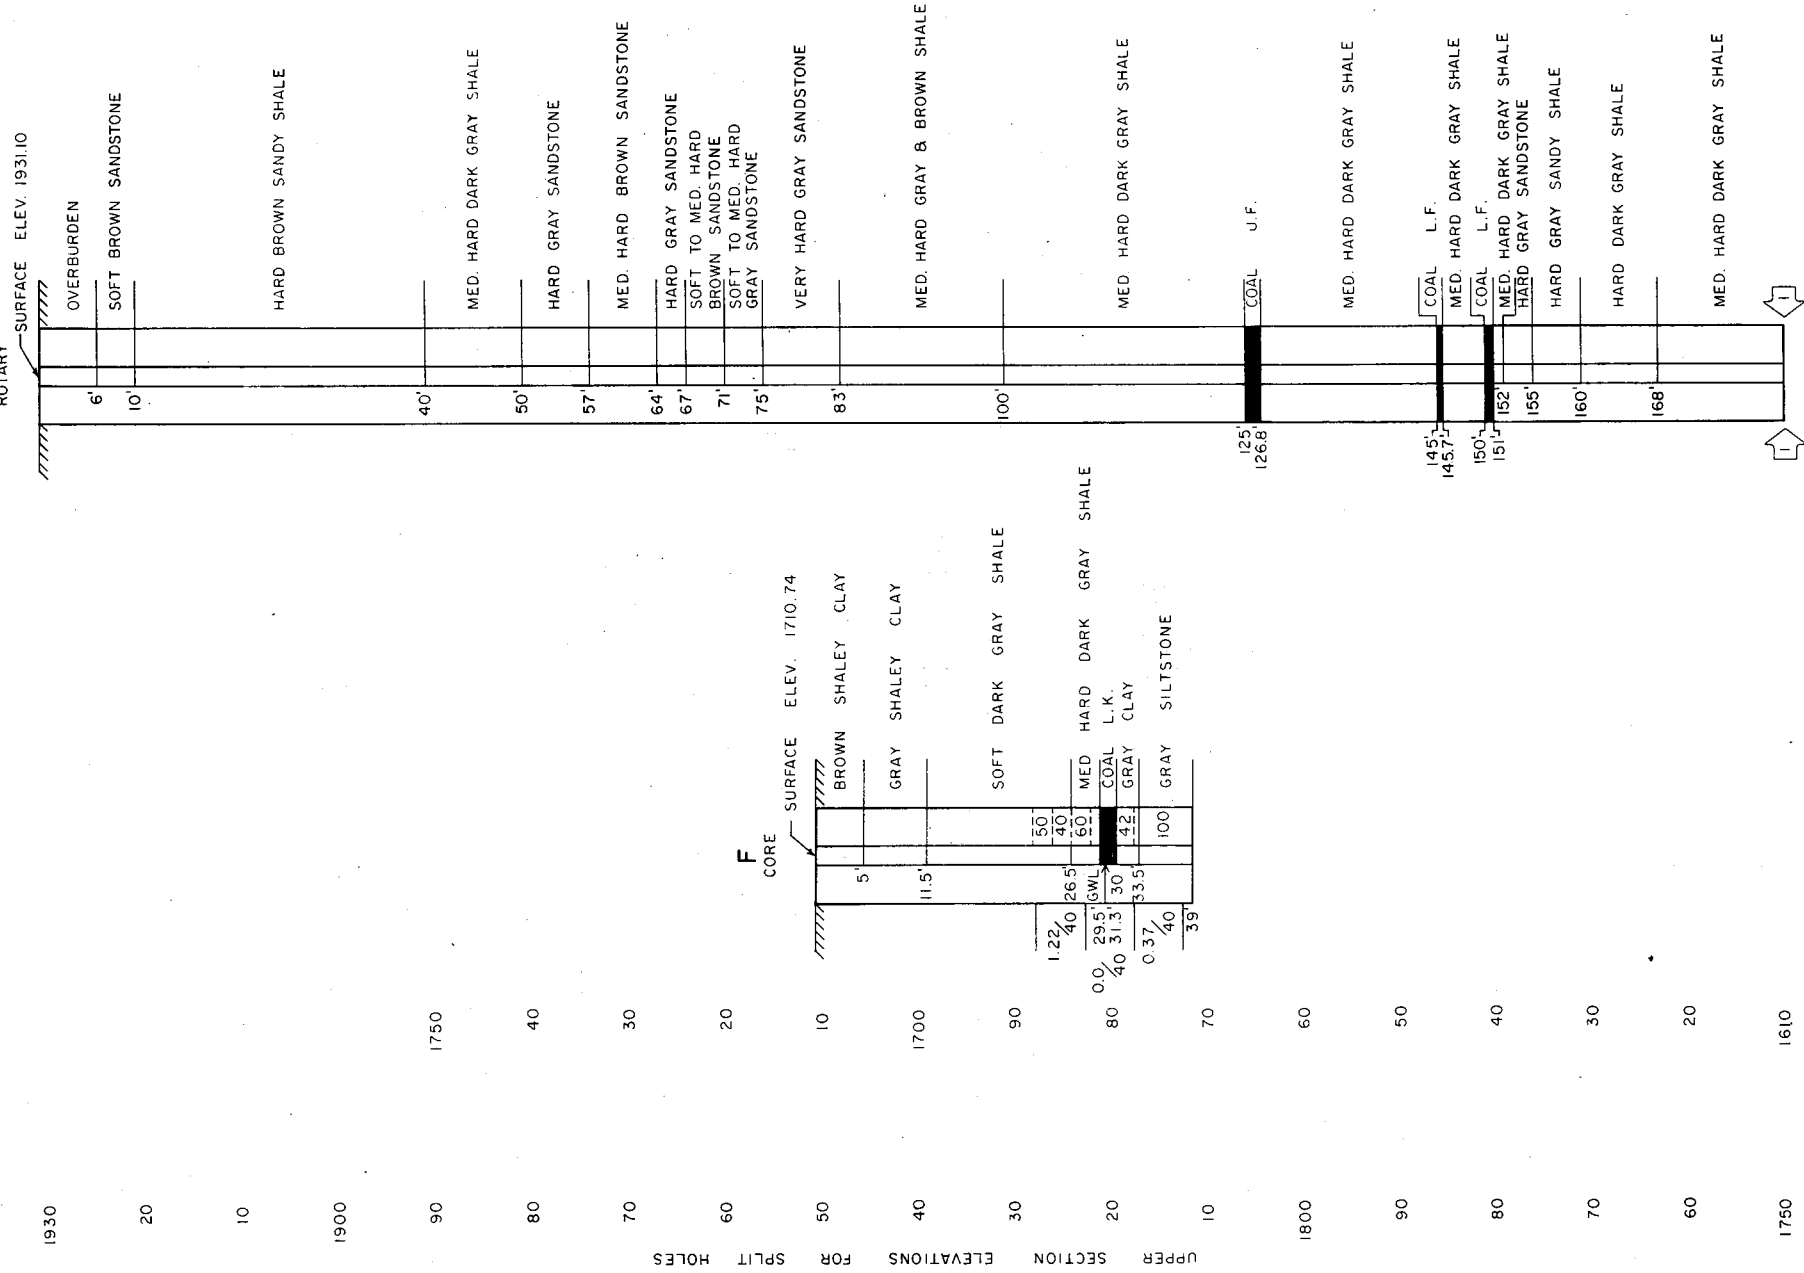


G (1750-1619.10)

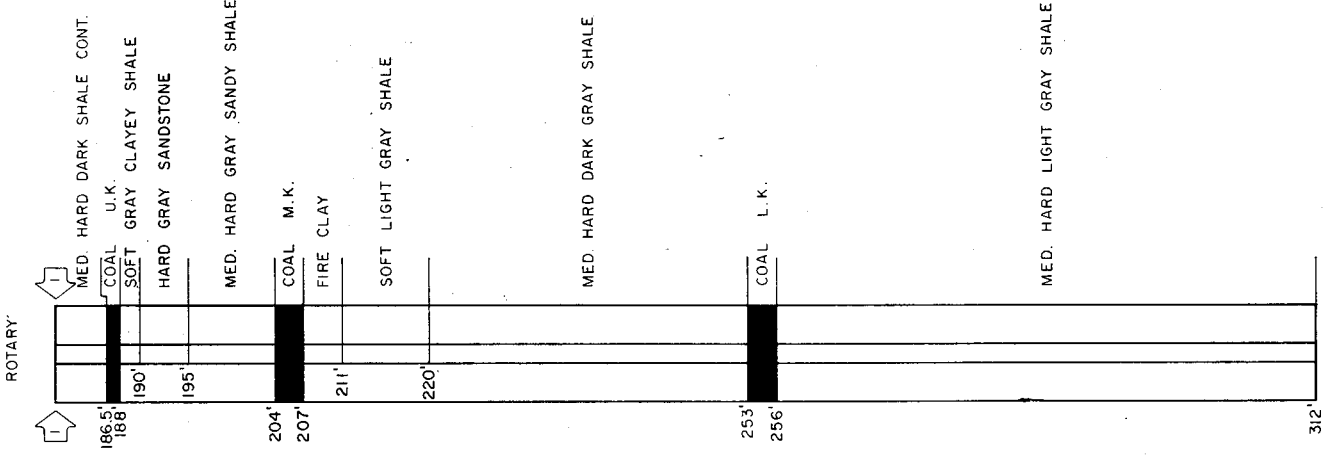


F

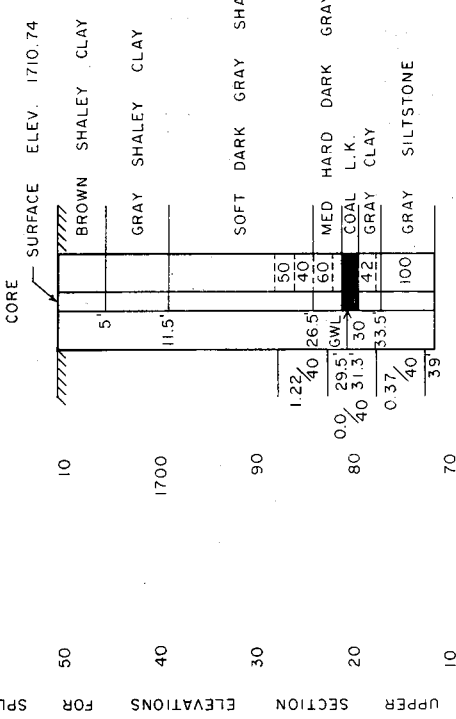

H

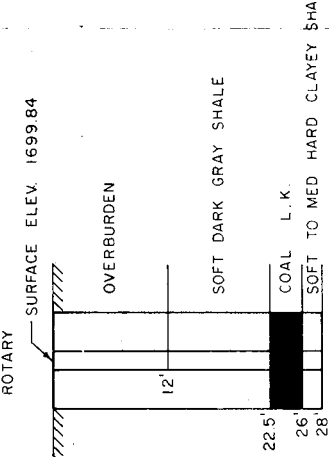

I

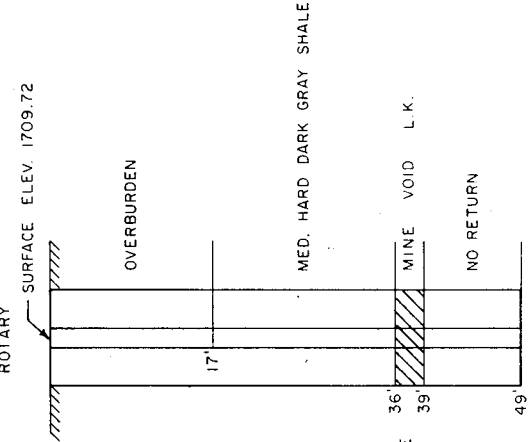

1930

20

10

1900

1750

40

30

20

10

1700

90

80

70

1800

90

80

70

60

1750

1930

20

10

1900

1750

40

30

20

10

1700

90

80

70

1800

90

1640

1880


DEPARTMENT OF ENVIRONMENTAL RESOURCES

PROJECT SL 132-5-101.5

LITTLE TOBY CREEK
ELK COUNTY


SUBSURFACE EXPLORATION


BORE HOLES
F, G, H, I

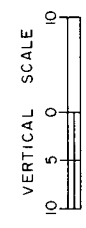





DEPARTMENT OF ENVIRONMENTAL RESOURCES
PROJECT SL 132-5-101.5
 LITTLE TOBY CREEK
 ELK COUNTY
SUBSURFACE EXPLORATION
BORE HOLES
K, L, M, N-1, N-3

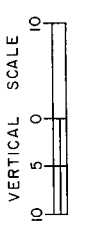

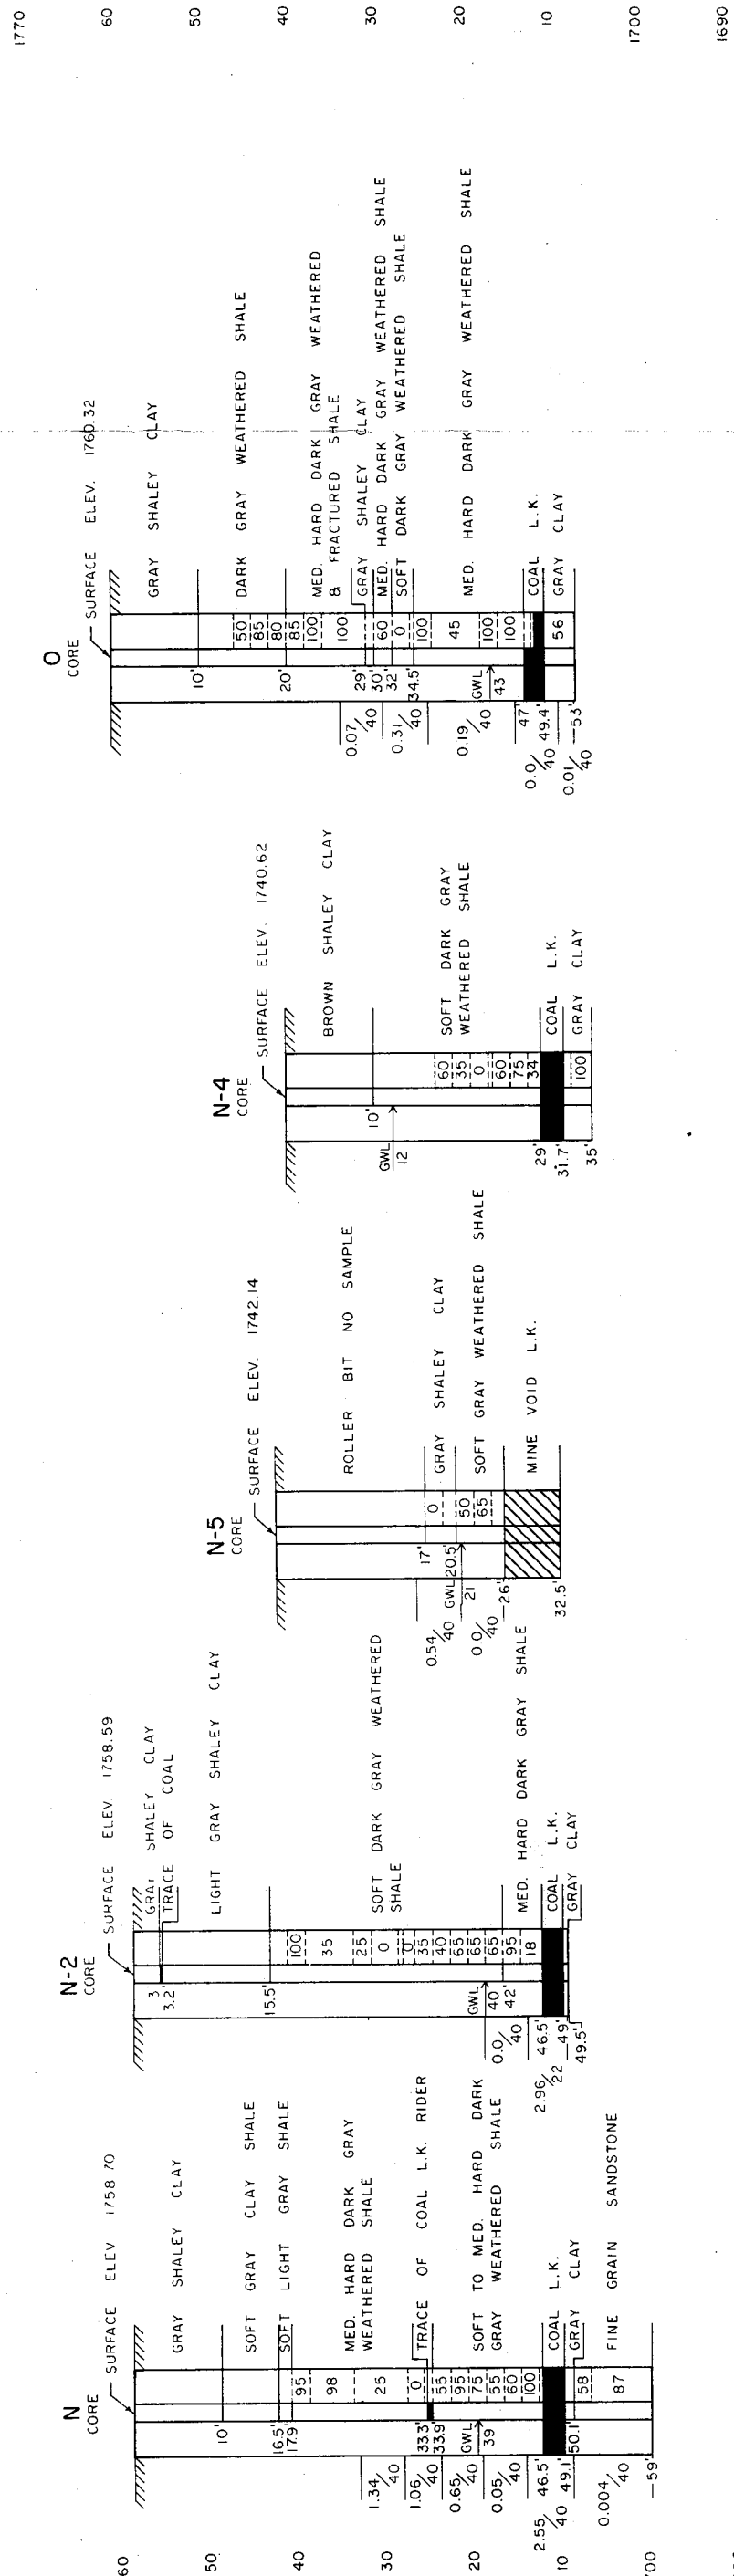



DEPARTMENT OF ENVIRONMENTAL RESOURCES
 PROJECT SL 132-5-101.5
 LITTLE TOBY CREEK
 ELK COUNTY
 SUBSURFACE EXPLORATION
 BORE HOLES
 N, N-2, N-5, N-4, 0

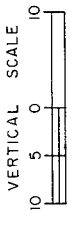

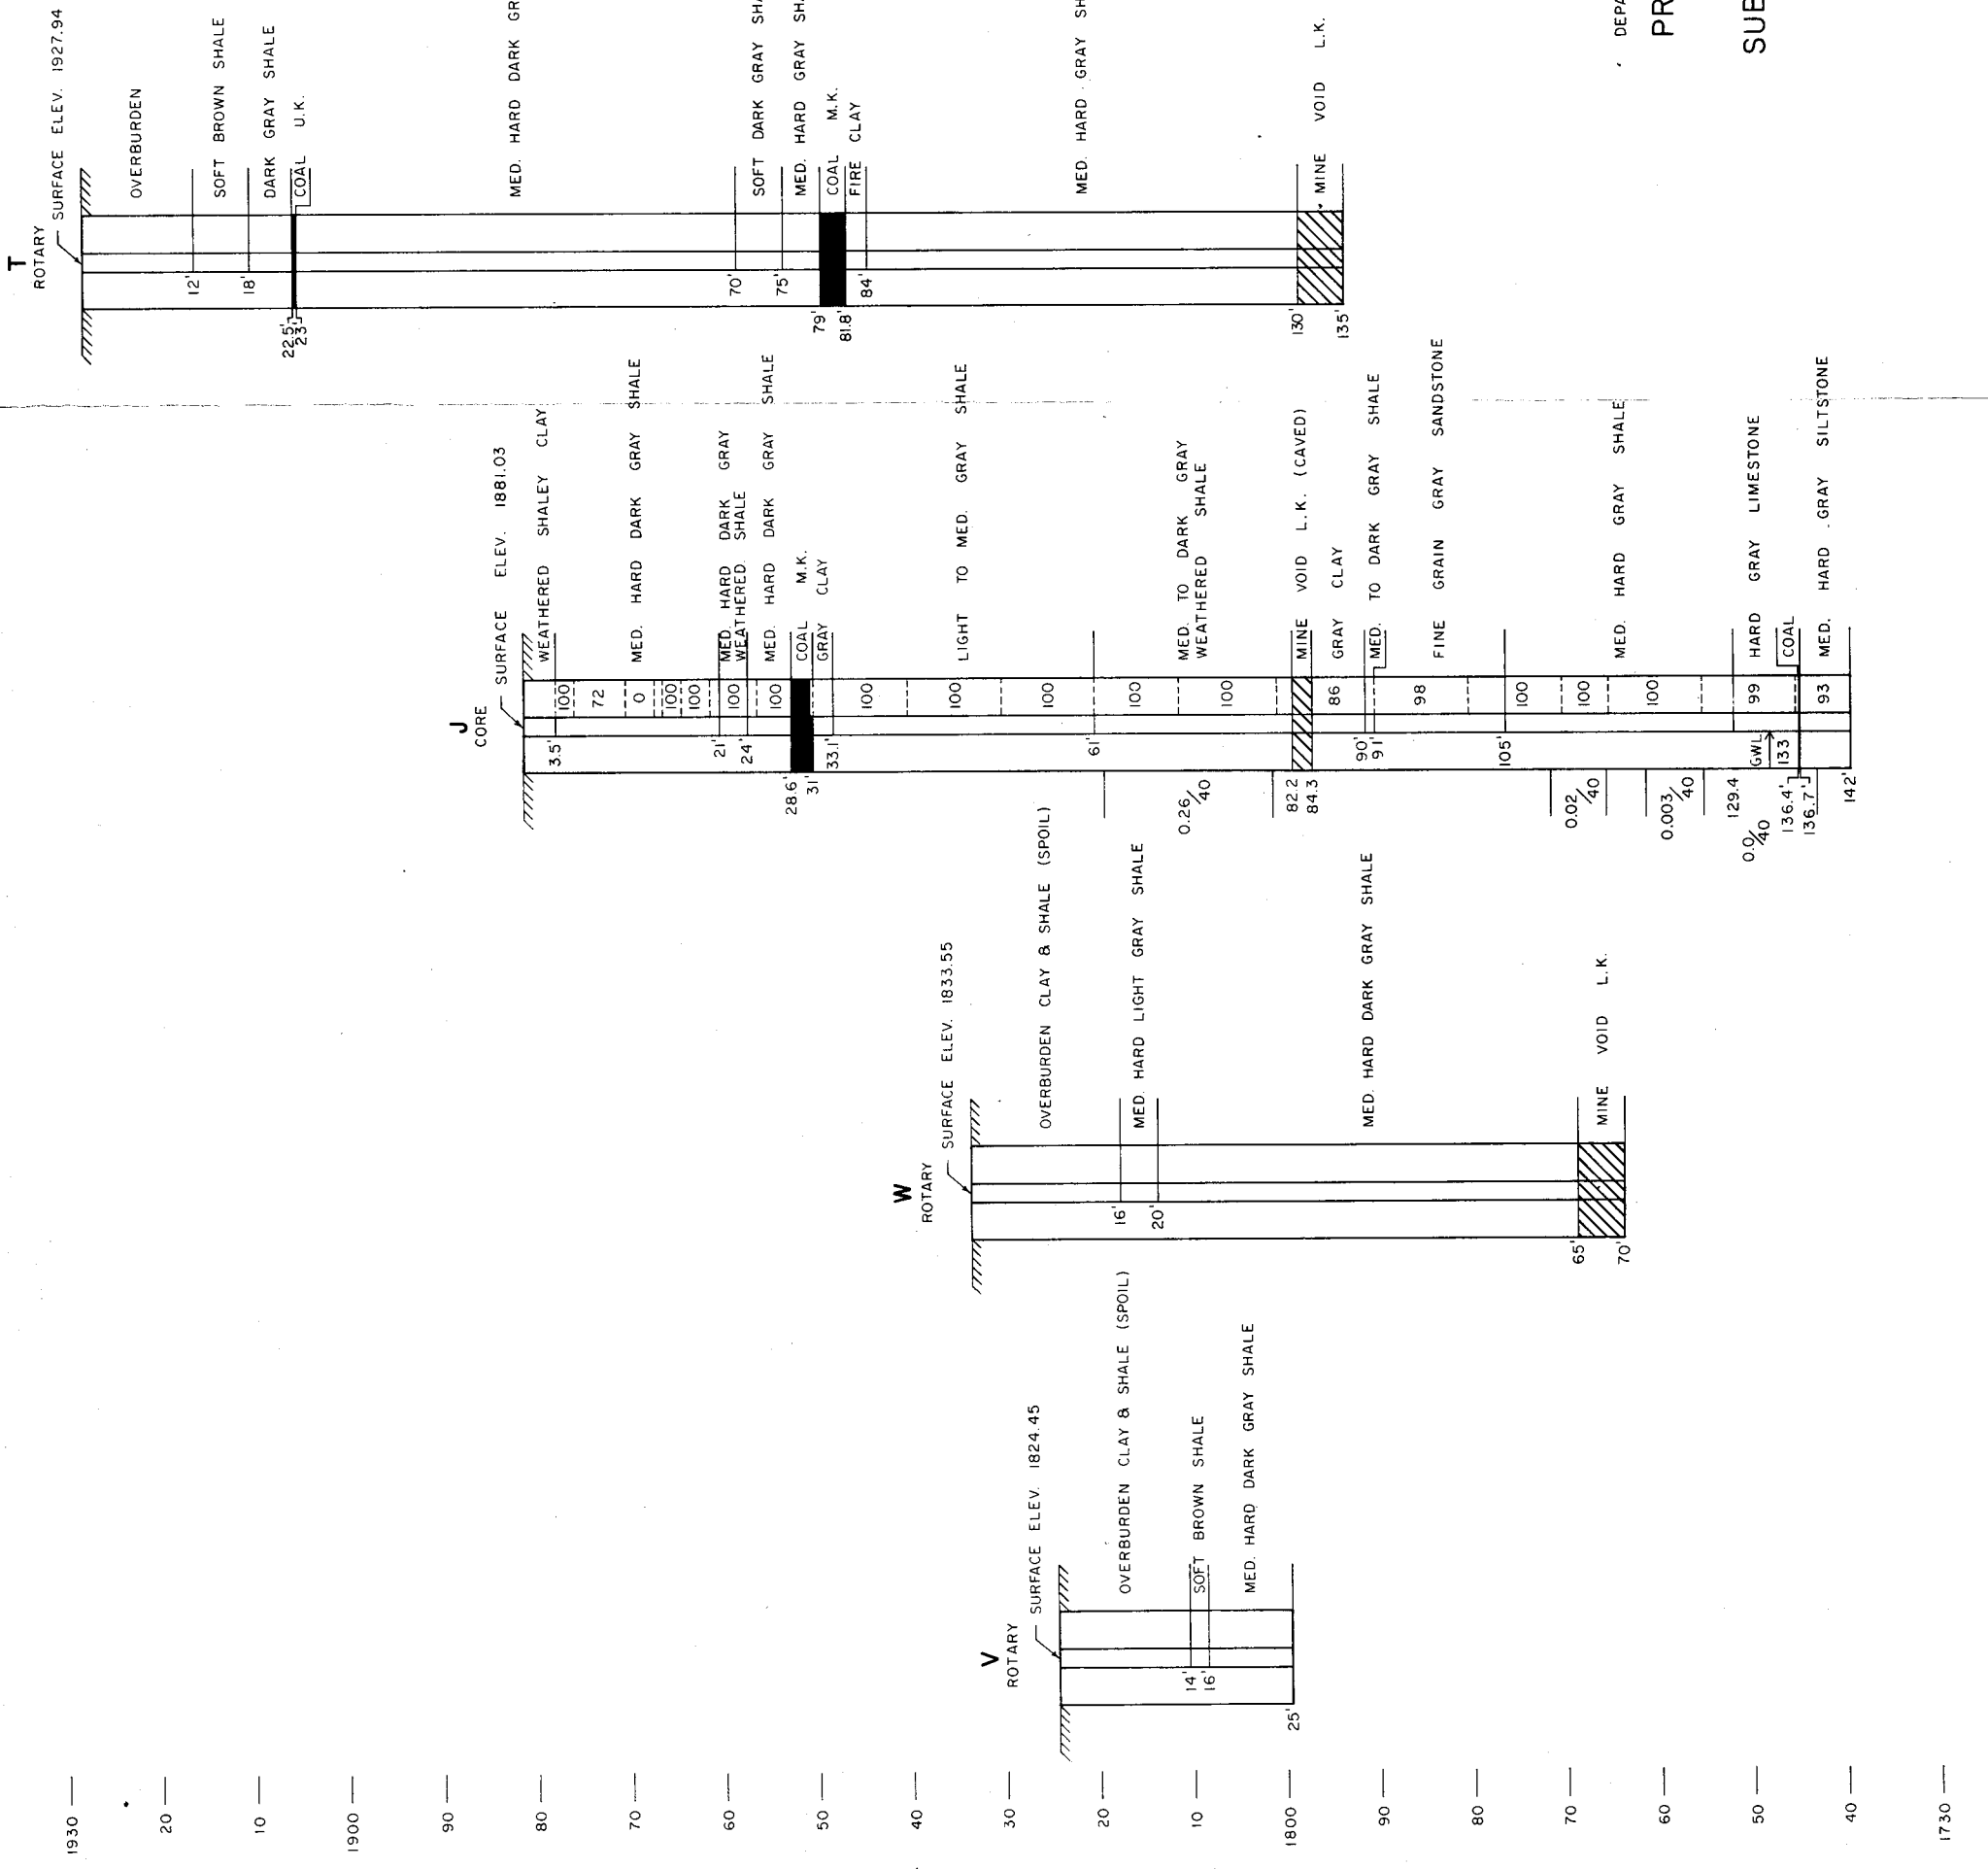


DEPARTMENT OF ENVIRONMENTAL RESOURCES
 PROJECT SL 132-5-101.5
 LITTLE TOBY CREEK
 ELK COUNTY
 SUBSURFACE EXPLORATION
 BORE HOLES
 V, W, J, T

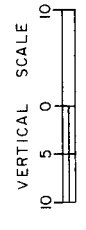

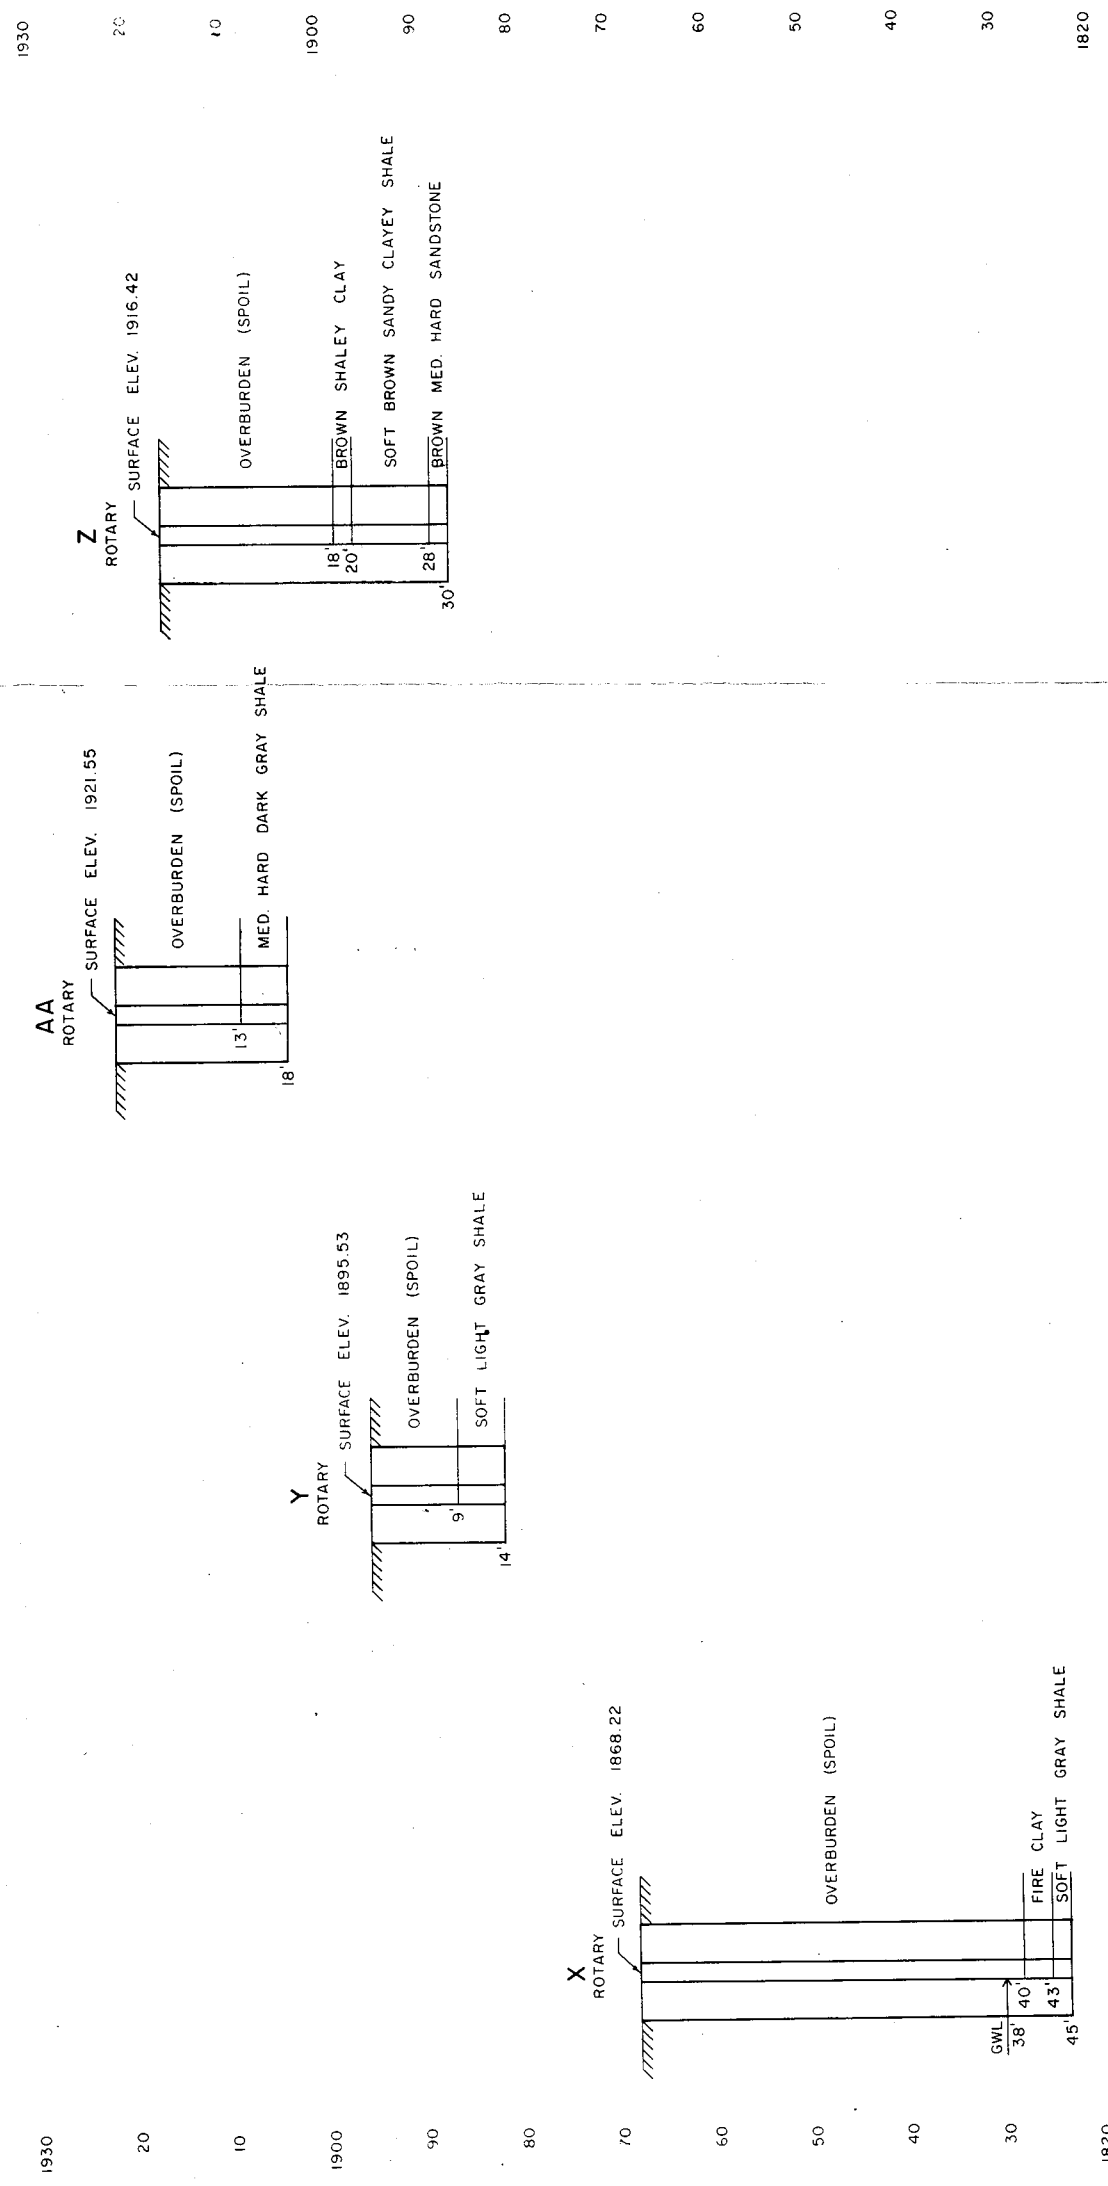


DEPARTMENT OF ENVIRONMENTAL RESOURCES
PROJECT SL 132-5-101.5
 LITTLE TOBY CREEK
 ELK COUNTY
SUBSURFACE EXPLORATION
 BORE HOLES
 X, Y, AA, Z

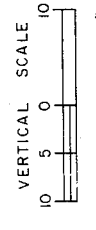


QQ (1947.57 - 1810)

CORE SURFACE ELEV. 1947.57

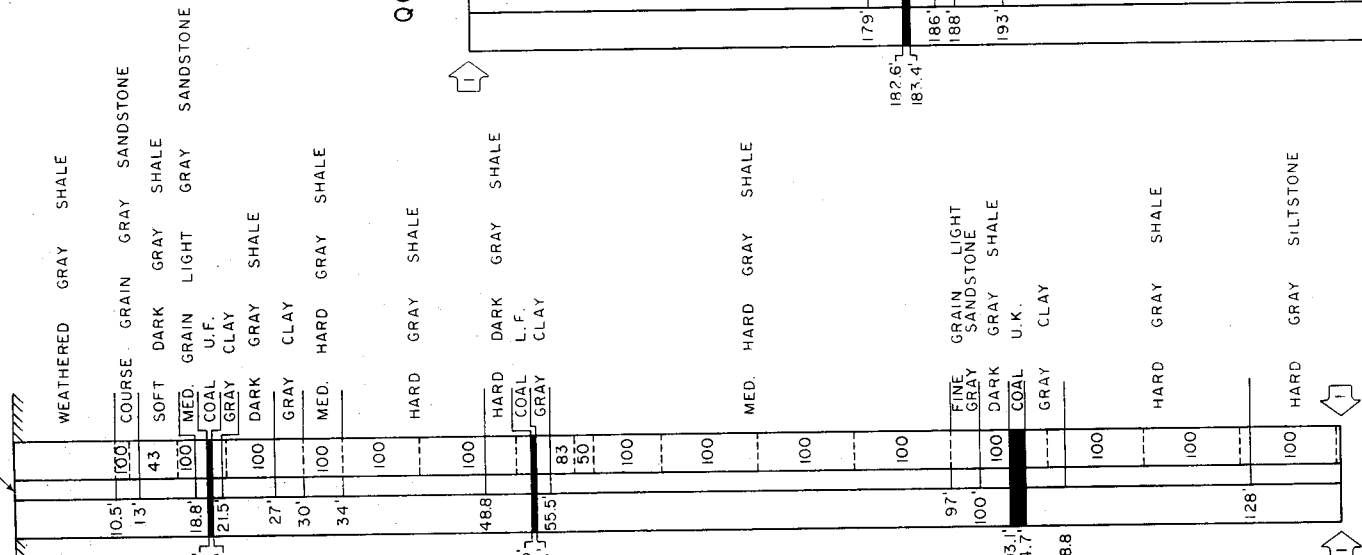


QQ (1810 - 1696.57)

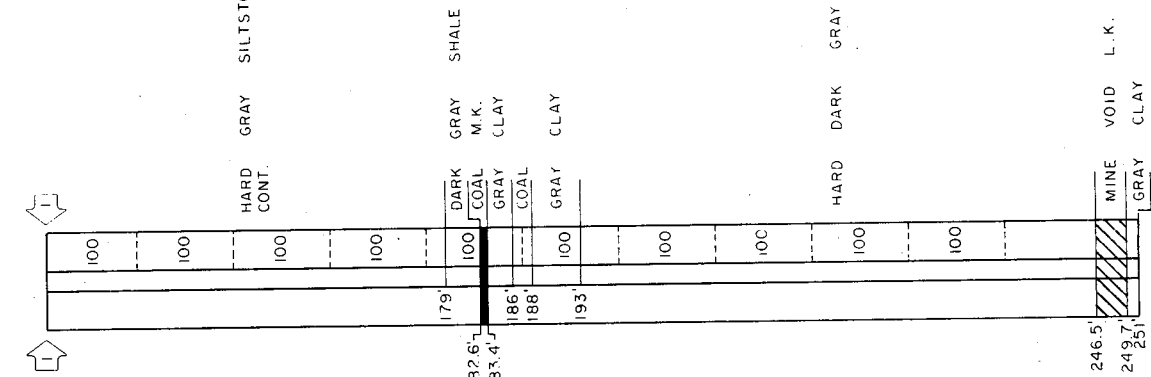


FF-1 (1933.04 - 1810)

ROTARY SURFACE ELEV. 1933.04

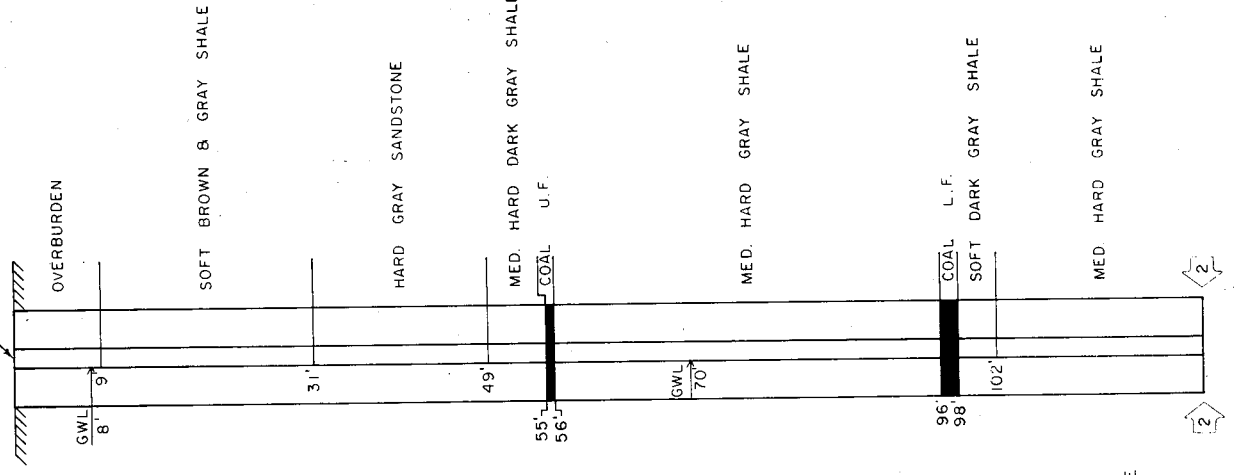


FF-1 (1810 - 1706.04)

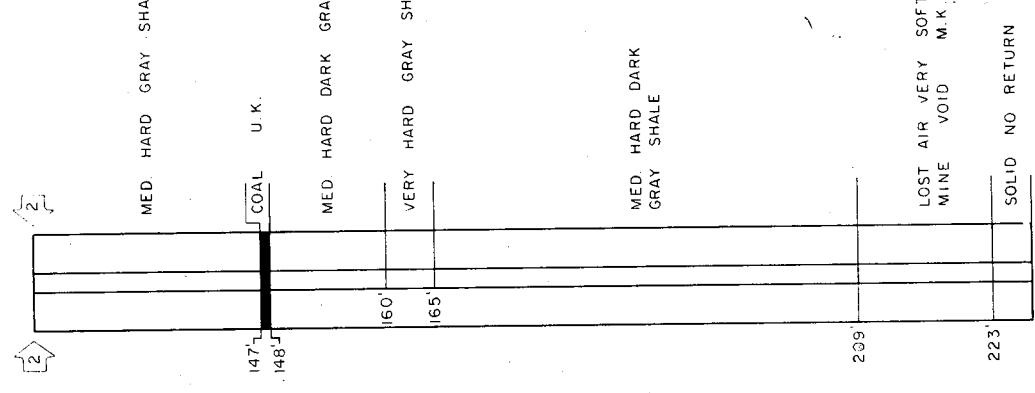


FF (1936.87 - 1810)

ROTARY SURFACE ELEV. 1936.87

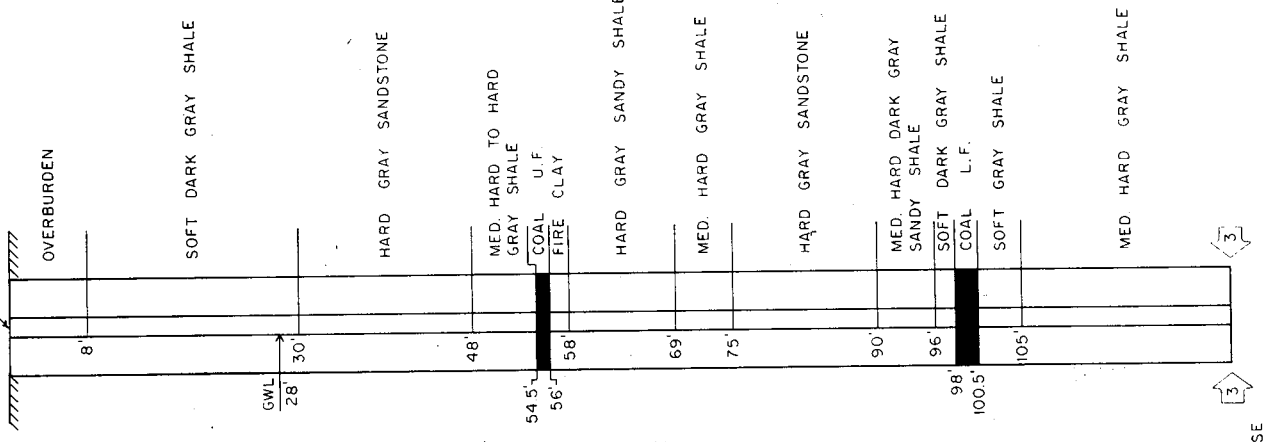

FF (1810 - 1709.87)

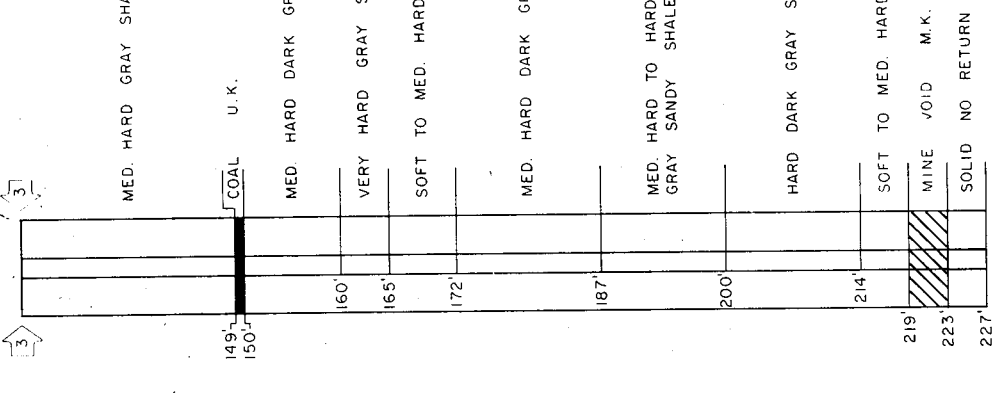


DEPARTMENT OF ENVIRONMENTAL RESOURCES

PROJECT SL 132-5-101.5

LITTLE TOBY CREEK
ELK COUNTY


SUBSURFACE EXPLORATION

BORE HOLES
QQ, FF-1, FF

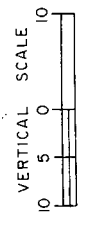


KK (1859.18 - 1710)

ROTARY SURFACE ELEV. 1859.18

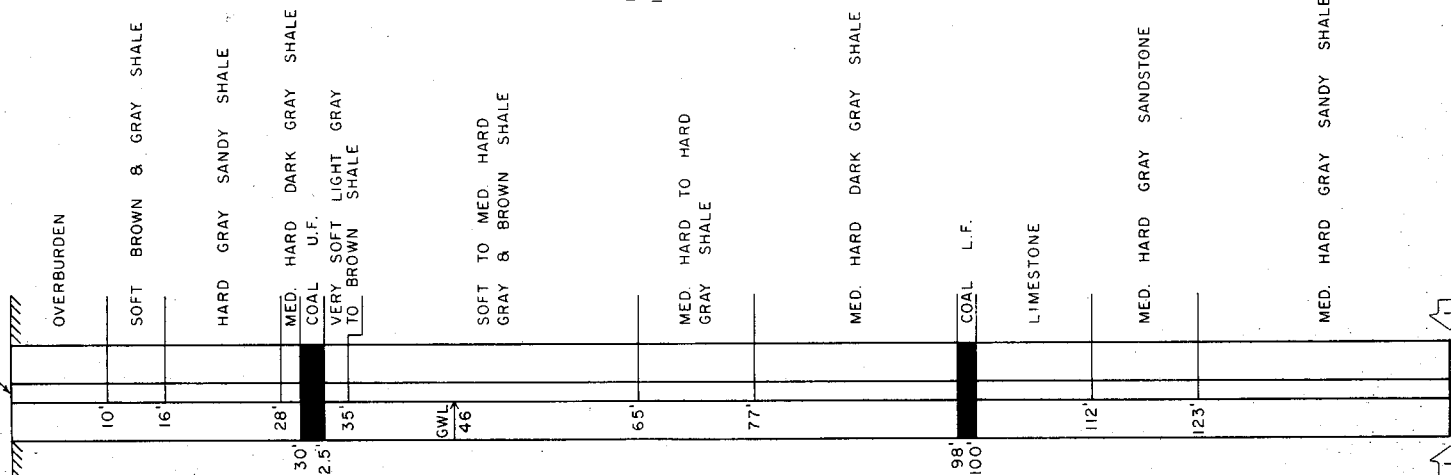


KK (1710 - 1649.18)

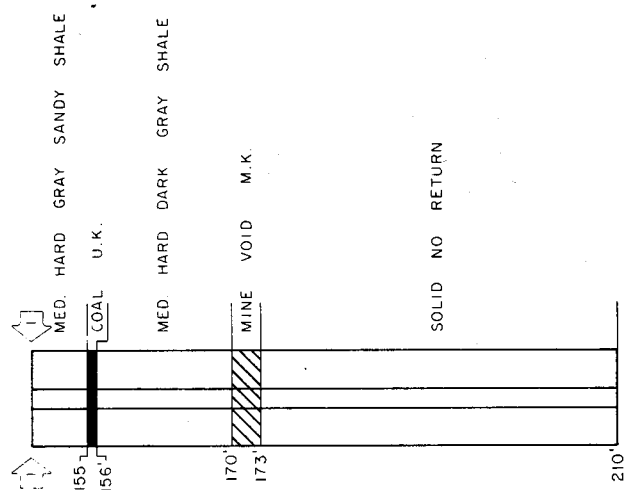


EE

SURFACE ELEV. 1749.42

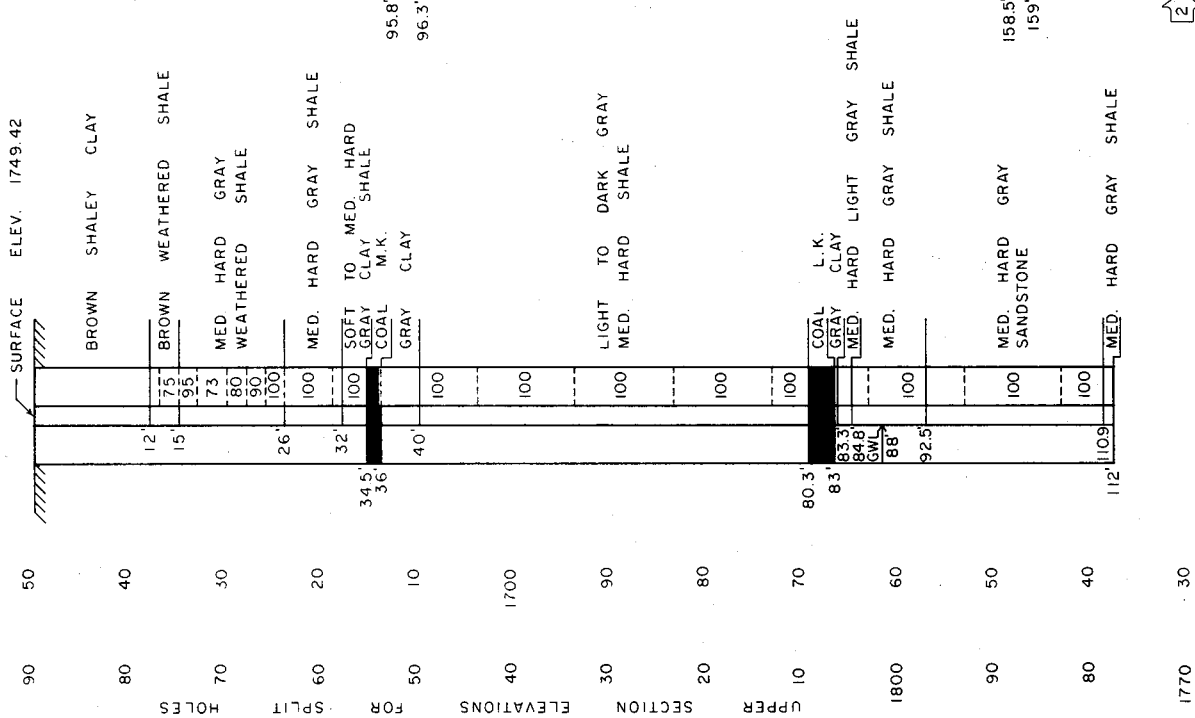


PP (1946.78 - 1770)


CORE SURFACE ELEV. 1946.78

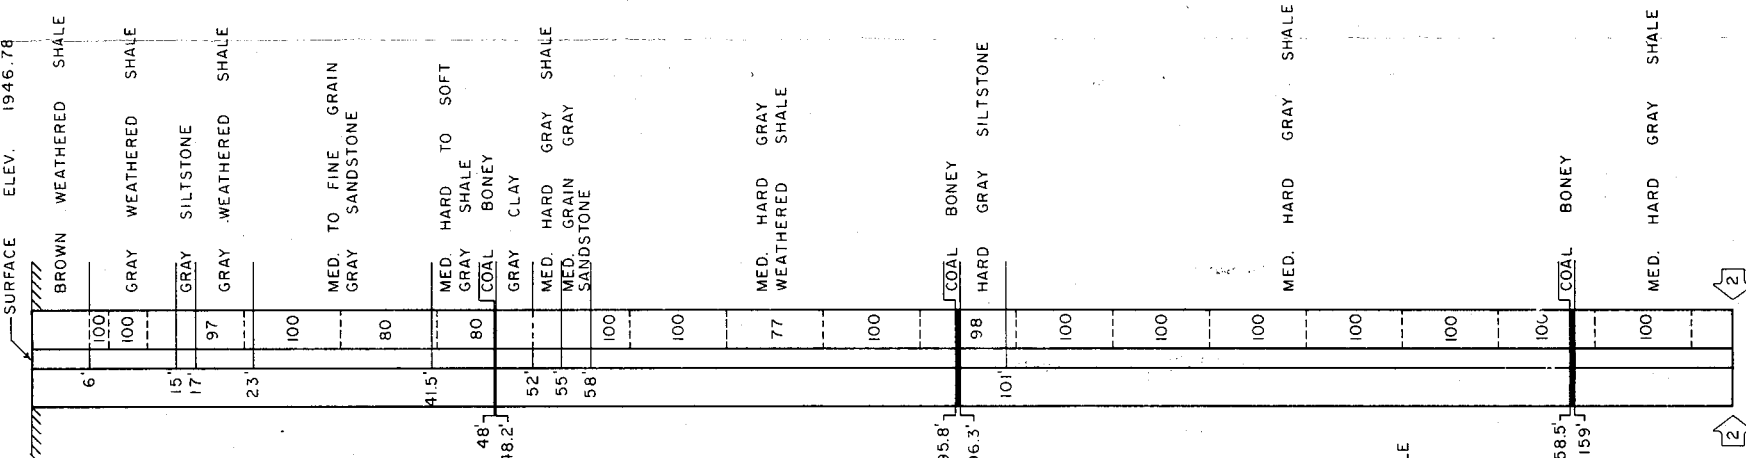


PP (1770 - 1704.78)

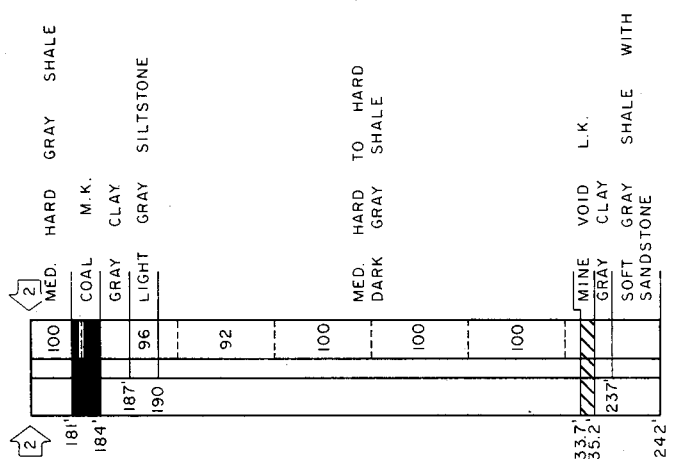

DEPARTMENT OF ENVIRONMENTAL RESOURCES
 PROJECT SL 132-5-101.5
 LITTLE TOBY CREEK
 ELK COUNTY
 SUBSURFACE EXPLORATION
 BORE HOLES
 KK, EE, PP

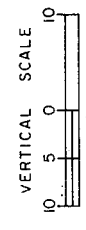

II (1895.09 - 1710)

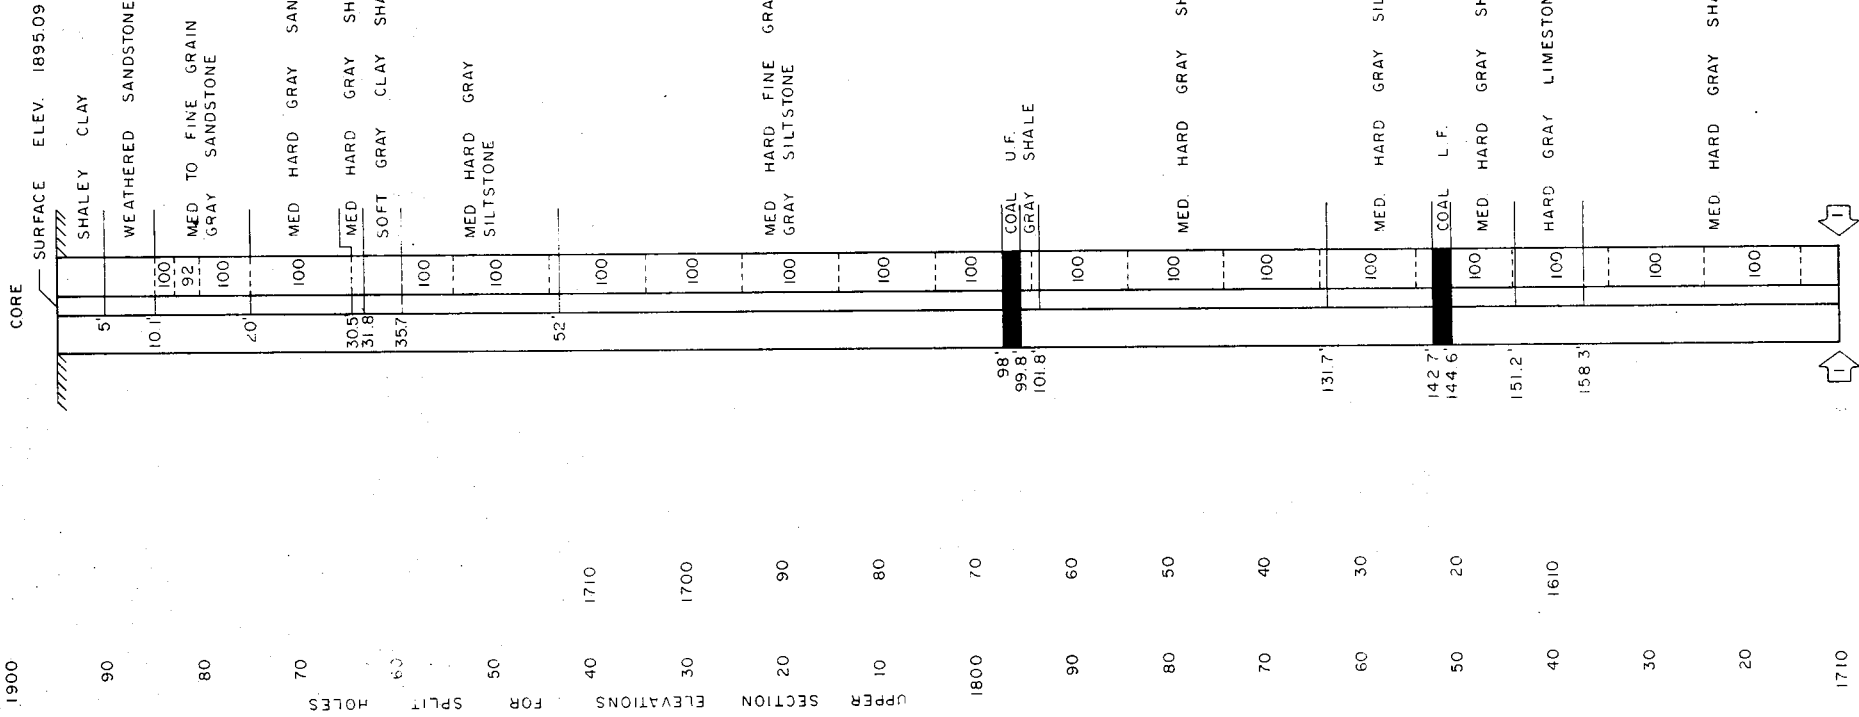

1890

80

70

60

50

40

30

20

10

1800

90

80

70

60

50

40


30

20


10

1710


JJ (1710 - 1613.97)

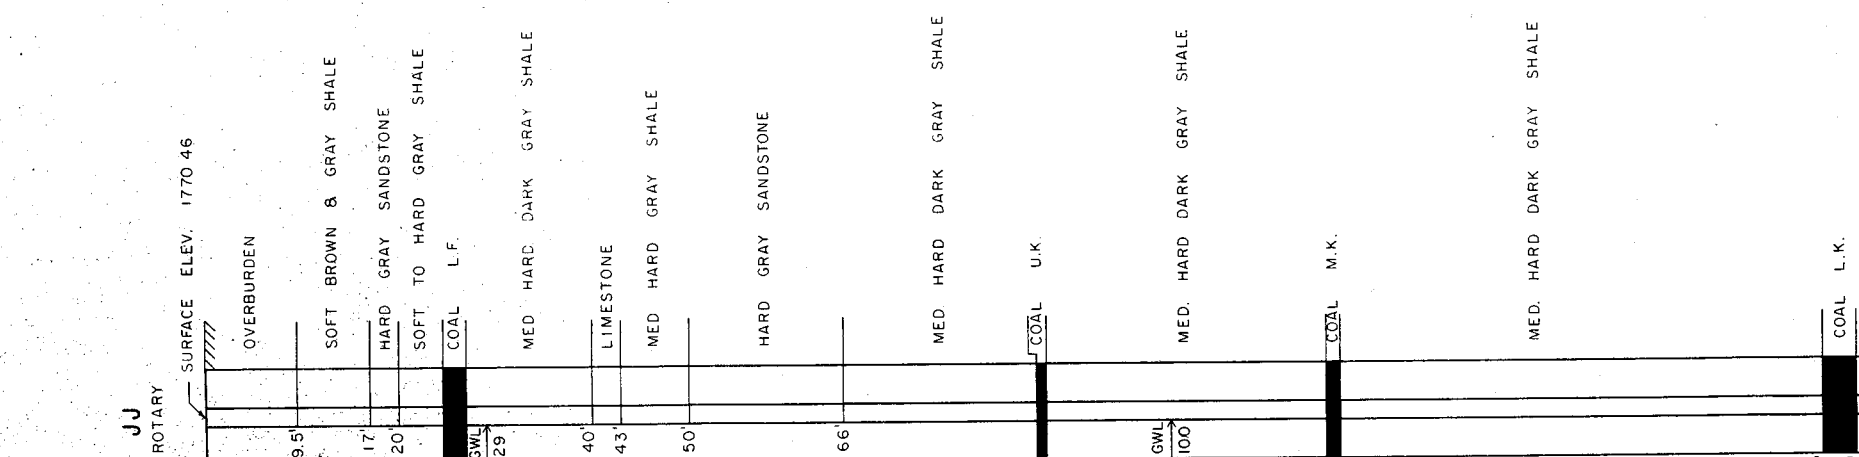


LL (1710 - 1613.97)

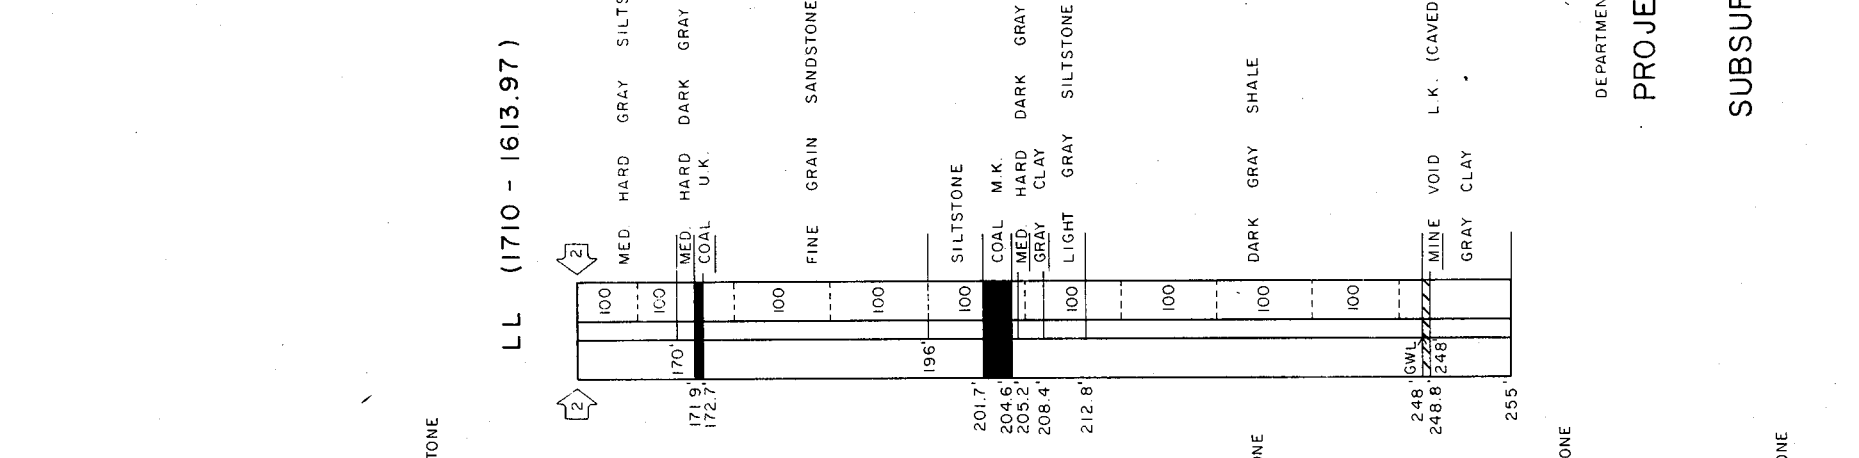

LL (1868.97 - 1710)

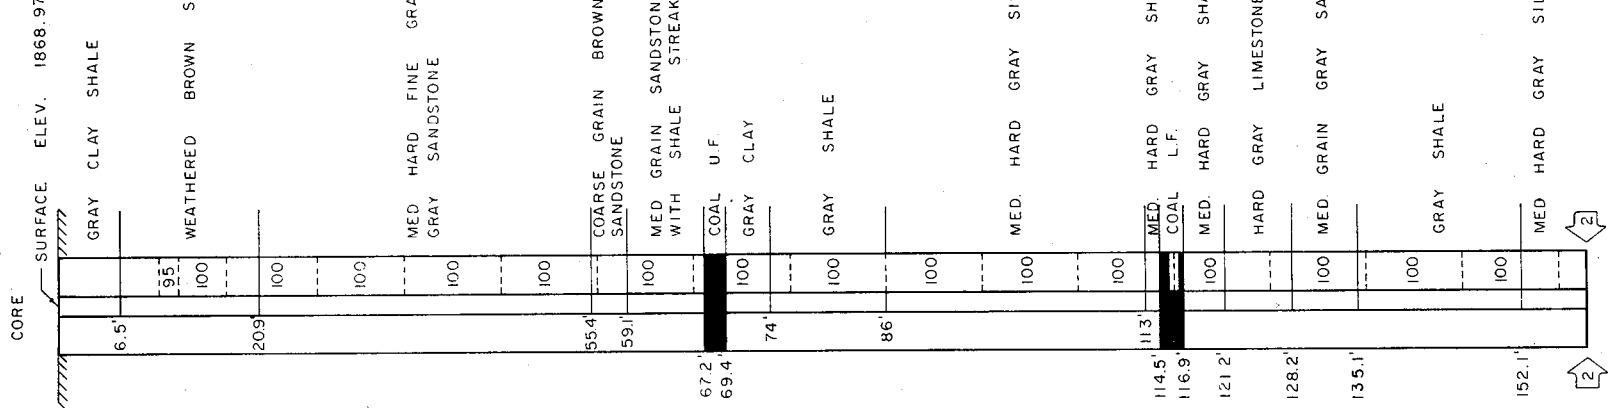

II (1710 - 1613.09)

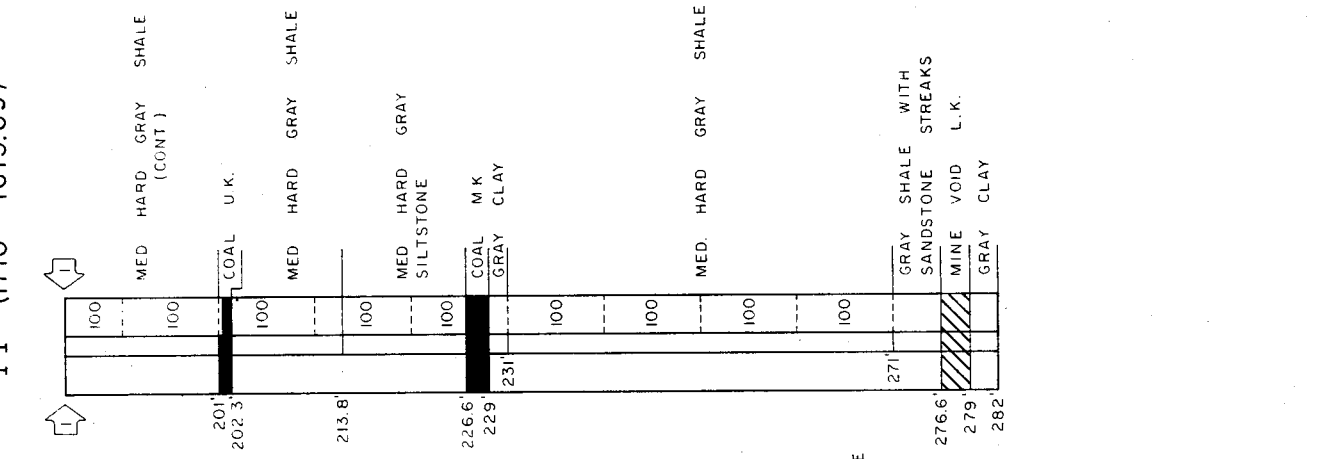

DEPARTMENT OF ENVIRONMENTAL RESOURCES
 PROJECT SL 132-5-101.5
 LITTLE TOBY CREEK
 ELK COUNTY
 SUBSURFACE EXPLORATION
 BORE HOLES
 JJ, II, LL

